

SURVEY for H. J. CHANDLER


IN SW 1/4 SEC. 11-T.28S.-R.6W.-W.M.

Scale - 1 in. = 40 ft.

March 1975

- ⊕ Iron Pipe Found
- 5/8" Iron Rod Set

COUNTY SURVEYORS FILE DATA
DO NOT REMOVE FROM OFFICE

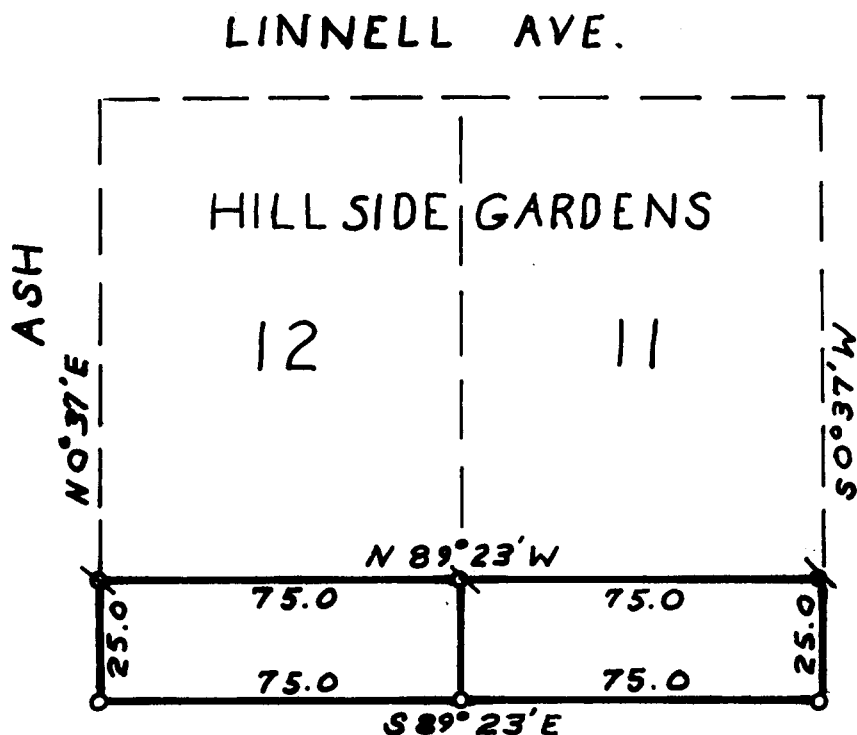

I, Howard W. Johnstone, certify that I have properly surveyed and monumented the land as shown on this plat.

FILED ✓
RECEIVED KP

MAR 10 1975

COUNTY SURVEYOR
DOUGLAS COUNTY, ORE.

REGISTERED
PROFESSIONAL
LAND SURVEYOR

Howard W. Johnstone

OREGON
MAY 13, 1960
HOWARD W. JOHNSTONE
498