

SURVEY TO SET PROPERTY CORNERS IN BLOCK F, FETT-MOORE SUB. SECTION 1, T.27S. R.6W.W.M.

FOR: RANDOLPH DICKENS
BY: BAUGHMAN SURVEYING SERVICE

FILED ✓
RECEIVED 2/3

AUG 11 1975

AUGUST 1975

SCALE: 1" = 40'

COUNTY SURVEYOR
DOUGLAS COUNTY, ORE.

COUNTY SURVEYOR'S FILE DATA
DO NOT REMOVE FROM OFFICE

Based on FETT-MOORE SUB.


LEGEND

- — Found 1/2" iron pipe
- — Set 1/2" iron rod
- ⊙ — Found 5/8" iron rod

REGISTERED
PROFESSIONAL
LAND SURVEYOR

Eugene A. Bloom

OREGON
MAY 13, 1960
EUGENE A. BLOOM
492

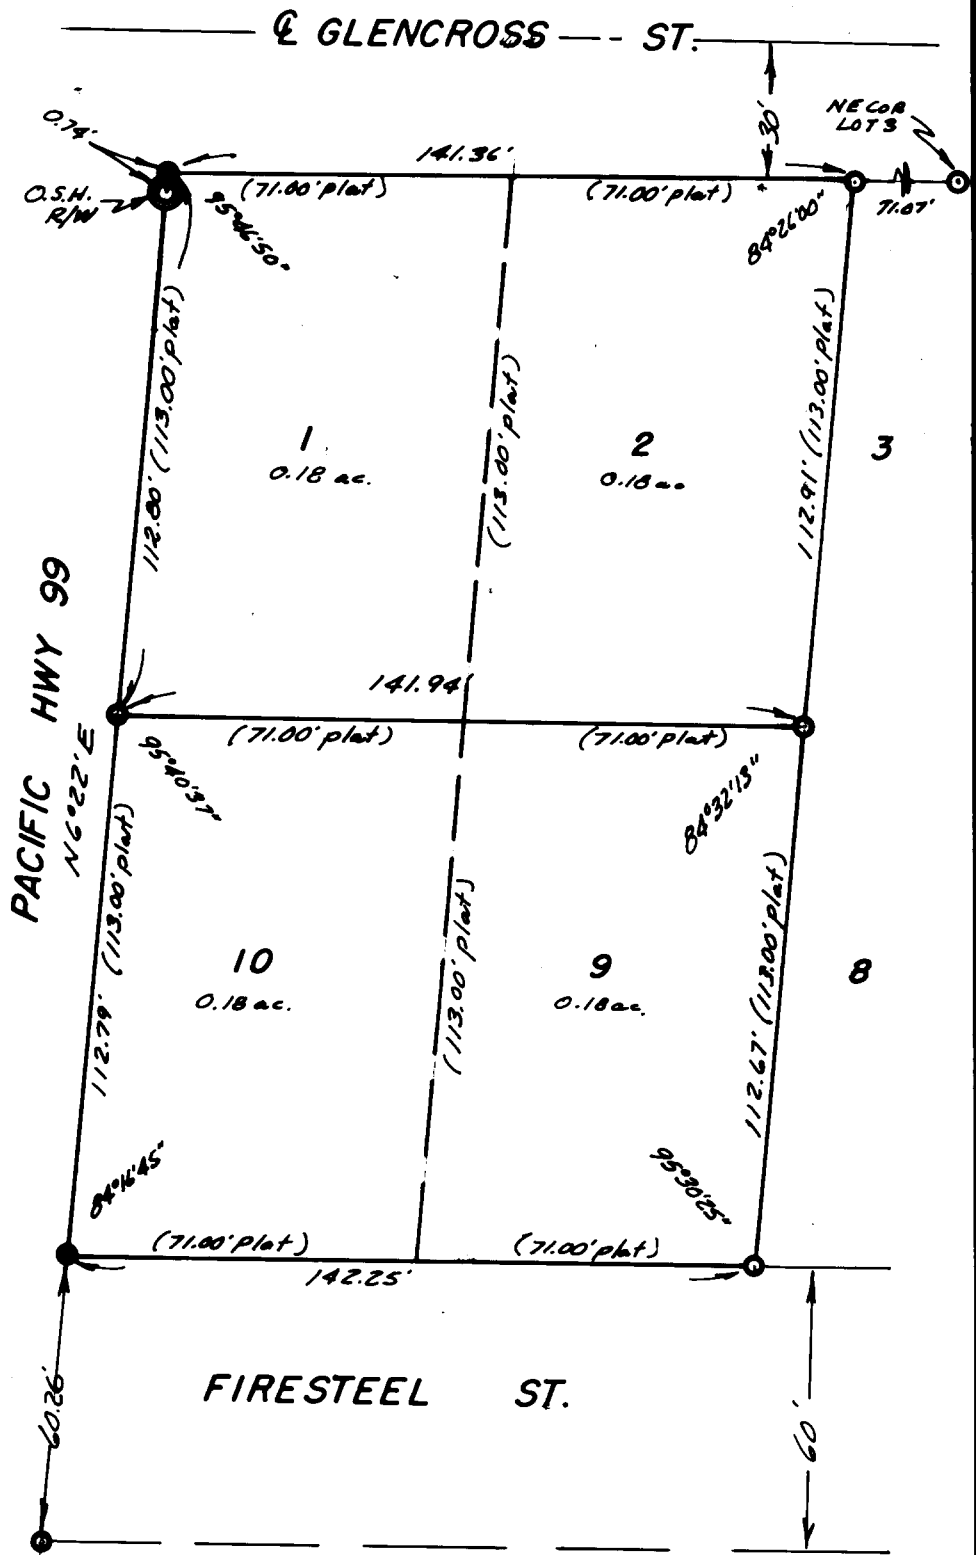

Job No. 35167

C. S. File No. C.S. 58/602