

# SURVEY TO SET PROPERTY CORNERS IN LOTS 7, 8, 9 & 10, BLOCK 4, AMENDED TOWNSITE OF SUTHERLIN SECTION 17, T.25S. R.5W. W.M.

FOR: NORTHWEST PROPERTIES, INC.  
BY: BAUGHMAN SURVEYING SERVICE

AUGUST 1975  
COUNTY SURVEYORS FILE DATA  
DO NOT REMOVE FROM OFFICE

SCALE: 1" = 50'

FILED ✓  
RECEIVED ✓


AUG 11 1975

COUNTY SURVEYOR  
DOUGLAS COUNTY, ORE.

REGISTERED  
PROFESSIONAL  
LAND SURVEYOR

*Eugene A. Bloom*

OREGON  
MAY 13 1950  
EUGENE A. BLOOM  
S. C. 2

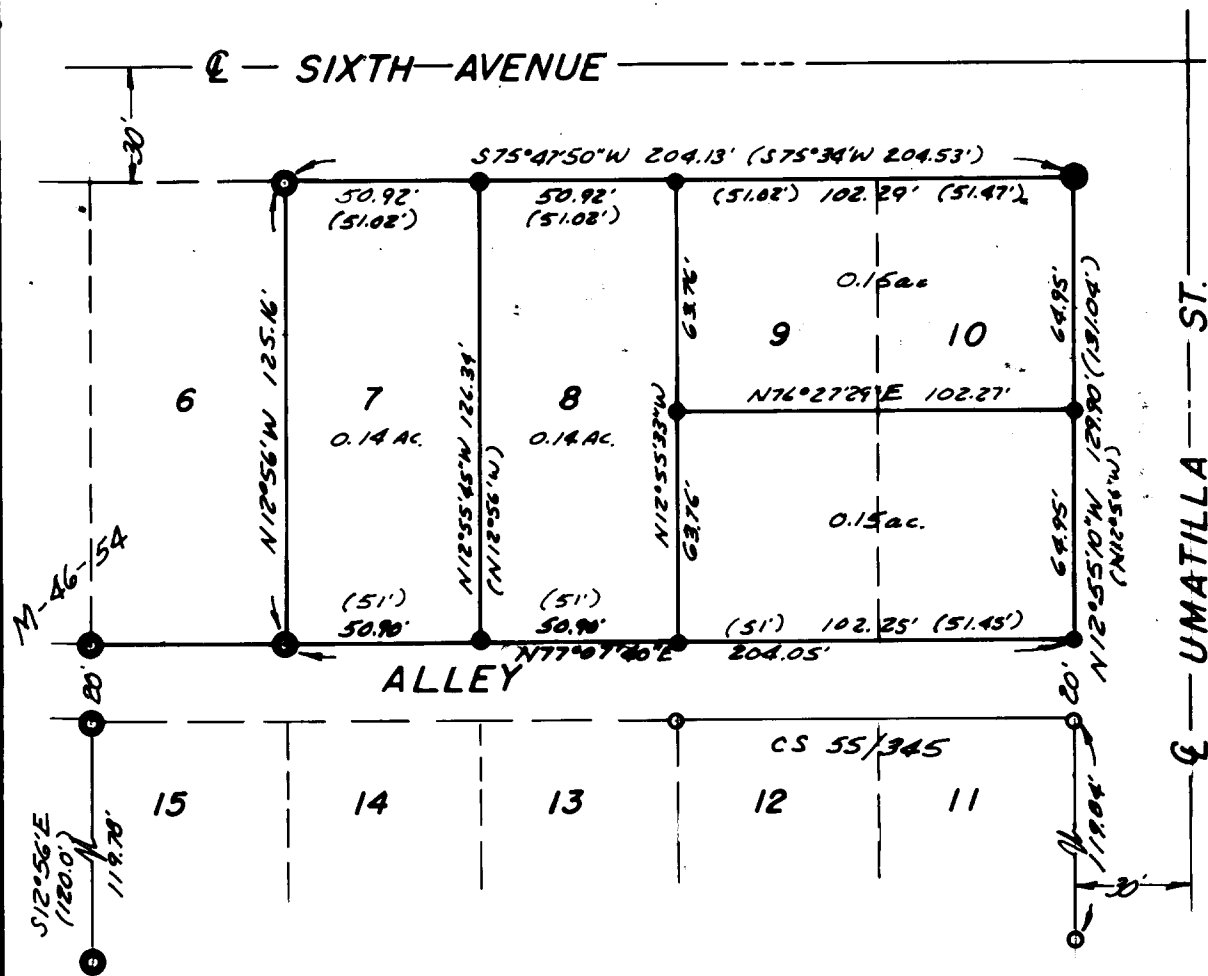

## LEGEND

- — Set 1/2" iron rod
- — Set 5/8" iron rod
- — Found 5/8" iron rod
- — Found 1/2" iron rod

Job No. 35145

C. S. File No. 58/61-1