

SURVEY TO SET PROPERTY CORNERS IN SECTION 7, T.30S. R.5W.W.M.

FOR: AGEE REALTY
BY: BAUGHMAN SURVEYING SERVICE


AUGUST 1975 SCALE: 1" = 50'
COUNTY SURVEYOR FILE DATA
DO NOT REMOVE FROM OFFICE

FILED ✓
RECEIVED ✓

AUG 11 1975

COUNTY SURVEYOR
TULASIE COUNTY, ORE.

N.E. COR. J.W. WEAVER
DLC #42 T.30S. R.5W.W.M.

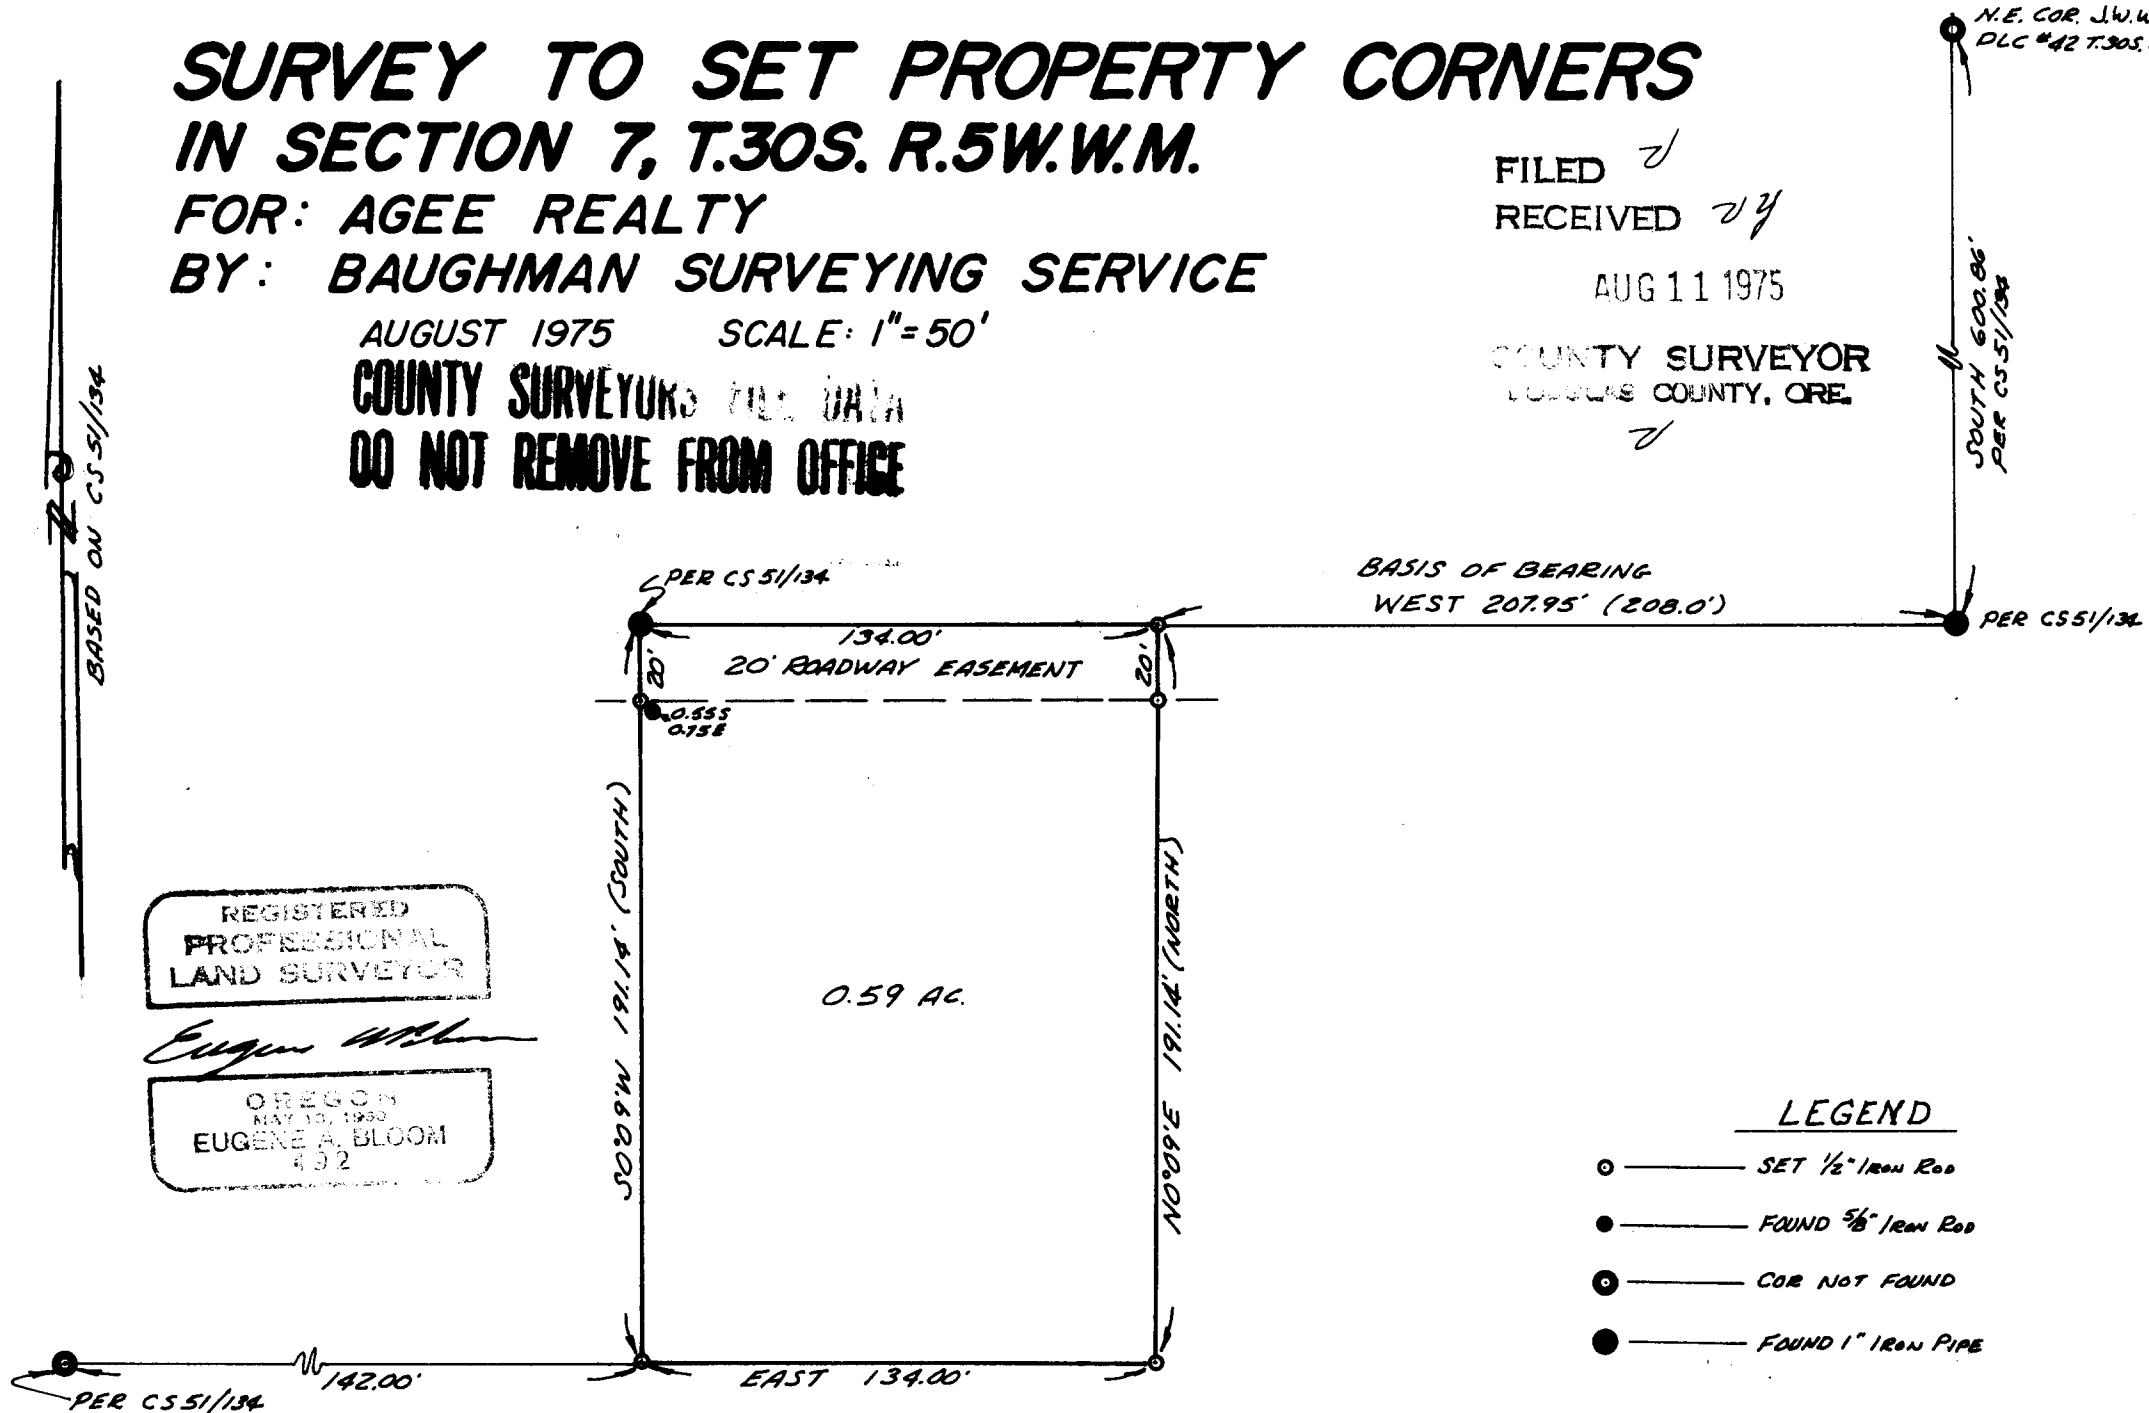

REGISTERED
PROFESSIONAL
LAND SURVEYOR

Eugene A. Bloom

OREGON
MAY 10, 1950
EUGENE A. BLOOM
432

LEGEND

- — SET 1/2" IRON ROD
- — FOUND 5/8" IRON ROD
- — COR NOT FOUND
- — FOUND 1" IRON PIPE

Job No. 35103

C. S. File No. 58/61-2