



1/4 COR.
FD. BRASS CAP PER
B.L.M. 1962 & 1 B.T.

29

28

N 89° 19' 43" W

5,323.68'

28 27

SECT. COR.
FD. 3/4" I. PIPE 28
& 1 B.T.

SECT. COR.
FD. 3/4" IRON
PIPE & 2 B.T.'S

21 22

05.619.2 W 151.55.000 N

1/4 COR.
FD. 3/4" IRON PIPE
& 2 B.T.'S


NE 1/4

FILED
RECEIVED
SEP 10 1975
COUNTY SURVEYOR
DOUGLAS COUNTY, OREGON

NOTE:

BEARINGS ARE REFERRED TO THE TRUE
MERIDIAN AND ARE BASED UPON SOLAR OBSERVATION.

COUNTY SURVEYORS FILE DATA
DO NOT REMOVE FROM OFFICE

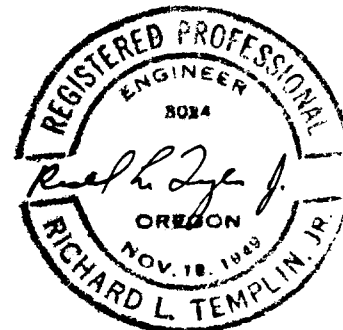


RICHARD L. TEMPLIN
CONSULTING ENGINEER

PLAT OF SURVEY
DEPENDENT SURVEY OF PORTION OF NE 1/4

LOCATED IN
SECTION 28, T.32 S., R.5 W., W.M.
DOUGLAS COUNTY, OREGON

Surveyed For: Rogue Valley Trees, Inc., Grants Pass, Ore.
Scale: 1" = 600' August 10, 1975.

Q.S. File No. 58164

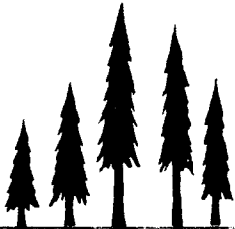

RICHARD L. TEMPLIN

CONSULTING ENGINEER

321 NORTHWEST A STREET
GRANTS PASS, OREGON 97526

COUNTY SURVEYORS FILE DATA
DO NOT REMOVE FROM OFFICE

REGISTERED ENGINEER OREGON
REGISTERED LAND SURVEYOR CALIF.

TEL. (503) 476-7114

August 10, 1975

SURVEY NARRATIVE

Location: Section 28, Township 32 South, Range 5 West, W. M.
Surveyed For: Rogue Valley Trees Inc. 620 S. W. fourth, Grants Pass.
Purpose: To mark the true lines for timber cutting purposes on the North half of the East line of Sect. 28 and the East half of the East-West centerline of Sect. 28.

I begin this survey at the 1/4 corner common to Sections 28 and 29, which is monumented with a brass cap per B. L. M. 1962 from which;

a Fir 12 inches in diam. bears S.71 W., 62 Lks., blaze healed.

I then run South $89^{\circ}19'43''$ East for 5,323.68 feet to the 1/4 corner common to Sections 27 and 28 which is monumented with a 3/4 diam. iron pipe, from which;

a Fir 32" in diam. bears S.85°E., 25.7 feet dist., blaze healed.

a Fir 16" in diam. bears N.68°W., 9.8 feet dist., blaze healed.

I then run N.00°35'15" West for 2,619.50 feet to the Sect. Cor. common to Sects. 27 and 28, which is monumented with a 3/4 inch diam. iron pipe, from which;

a Maple 13 inches in diam. bears S.20°E., 52.0 feet dist., scribe visible.

The northwest tree is down and dead, I mark a new tree ,
a D. Fir 50" in diam. bears S. 34 E., 35.0 feet dist. w/a partly healed blaze, with many years of overgrowth. I placed a marked location poster on the North side of the tree.

This survey was executed with a T16-ED Transite Theodolite and a Micro Ranger Electronic measuring instrument.

All bearings are referred to the true meridian and are based upon solar observations.



C. S. File No. 58/64b