


**COUNTY SURVEYORS FILE DATA  
DO NOT REMOVE FROM OFFICE**

SURVEY TO SET PROPERTY CORNERS  
THE WESTERLY 150 FT. OF LOT 16, BL. 2.  
FAIRACRES, IN SEC. 36, T. 26 S., R. 6 W. W.M.,  
FOR HAZEL MAUGER  
by BRUCE ROGERS  
FEB., 1976  
1" = 50'

FILED *Ymy*  
RECEIVED *RC*

FEB 20 1976

COUNTY SURVEYOR  
DOUGLAS COUNTY, ORE.

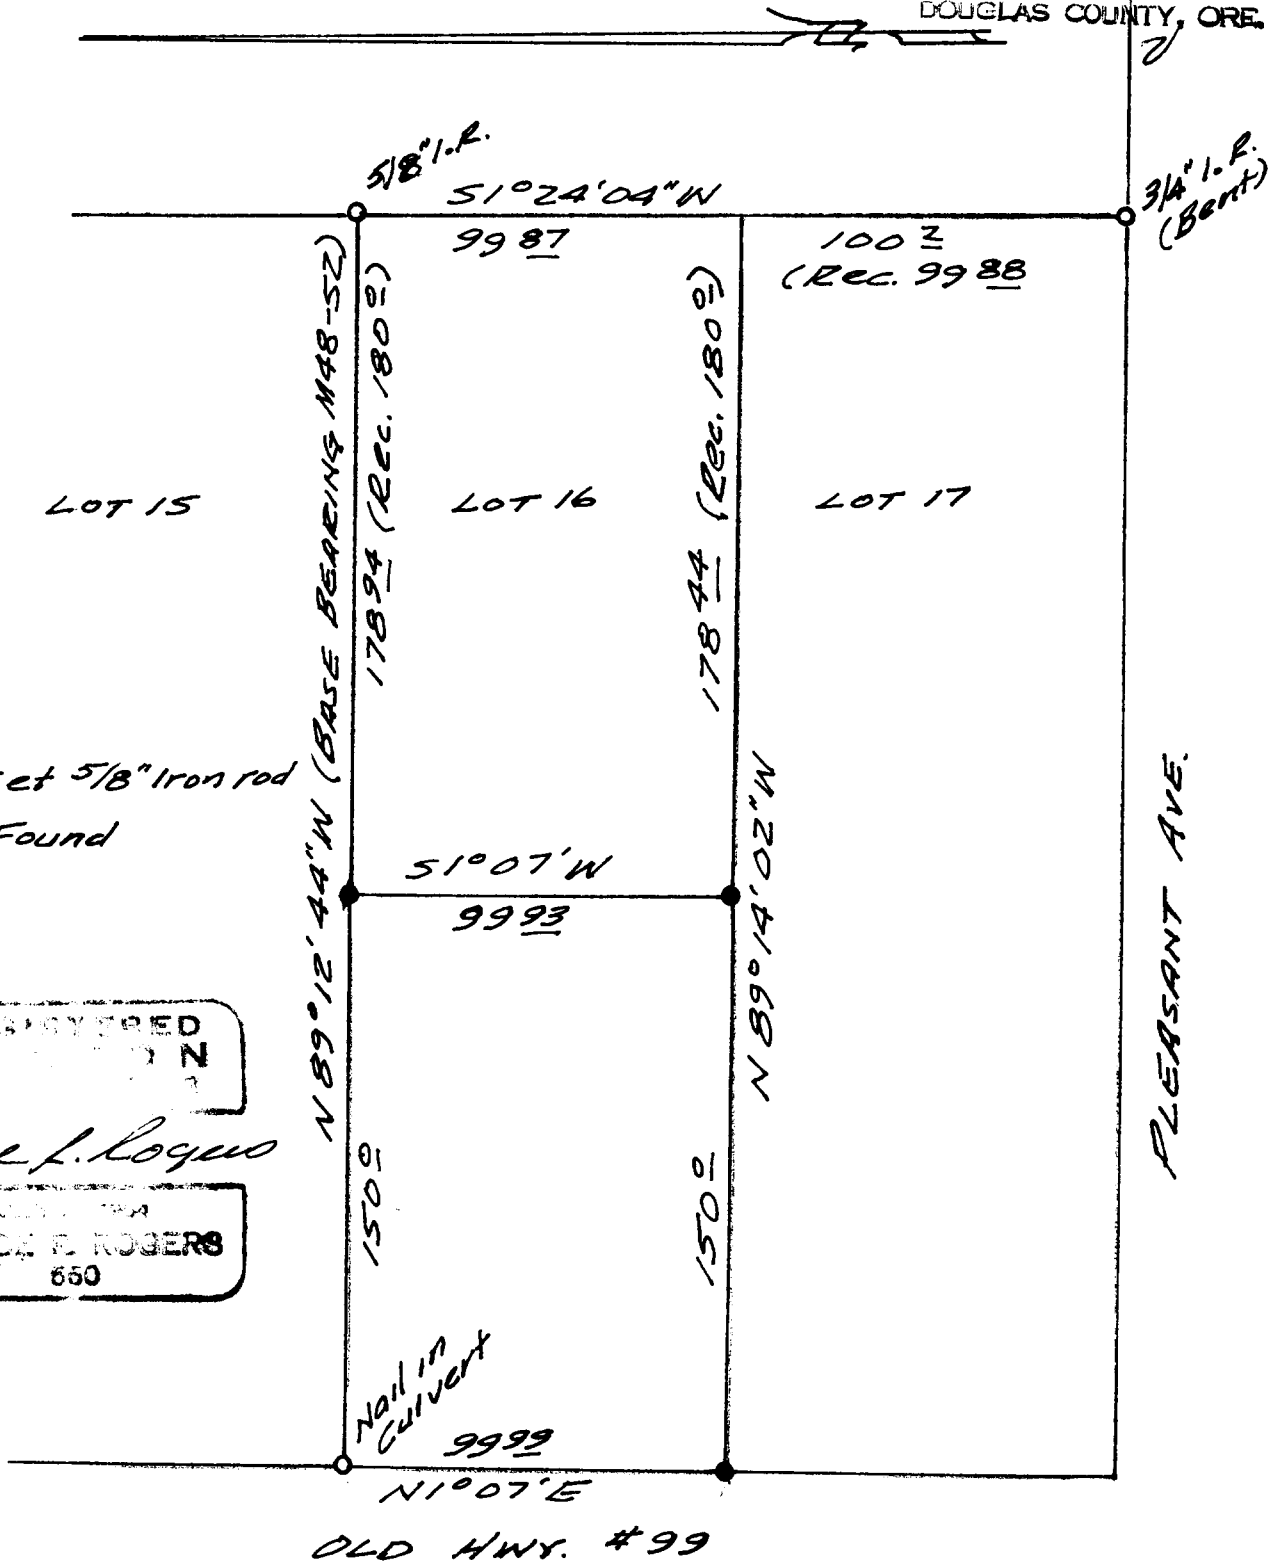

- - Set 5/8" Iron rod
- - Found

REGISTERED  
COUNTY SURVEYOR

*Bruce F. Rogers*

BRUCE F. ROGERS  
650