


25 30
 36 31
 T. 22S. R. 8W. N. 1/4
 T. 22S. R. 7W. N. 1/4

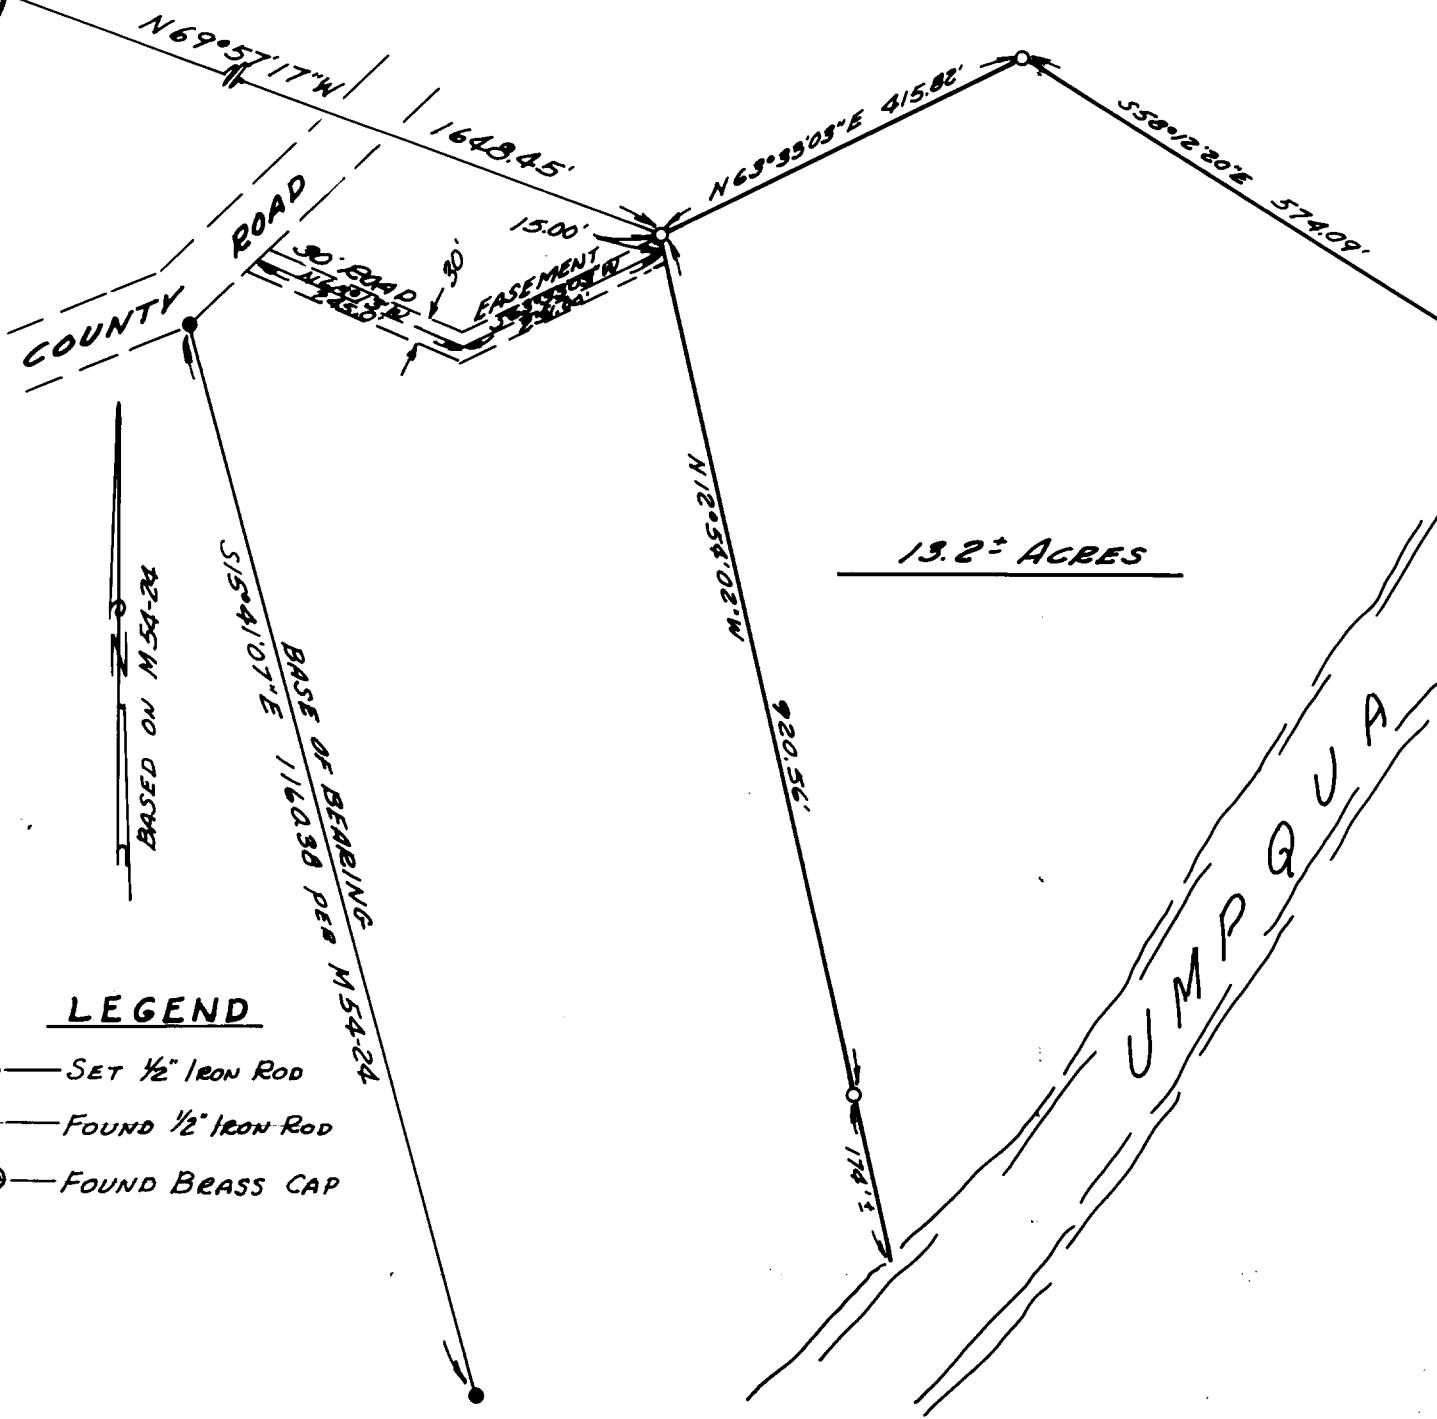

LEGEND

- — SET 1/2" IRON ROD
- — FOUND 1/2" IRON ROD
- ⊙ — FOUND BRASS CAP