


FILED ✓
RECEIVED *mg*

AUG 13 1975

COUNTY SURVEYOR
DOUGLAS COUNTY, ORE.
✓

CORNERS FND.
SET 5/8" I.R.'S
SET P.K. NAIL

COUNTY SURVEYORS FILE UNIT
DO NOT REMOVE FROM OFFICE

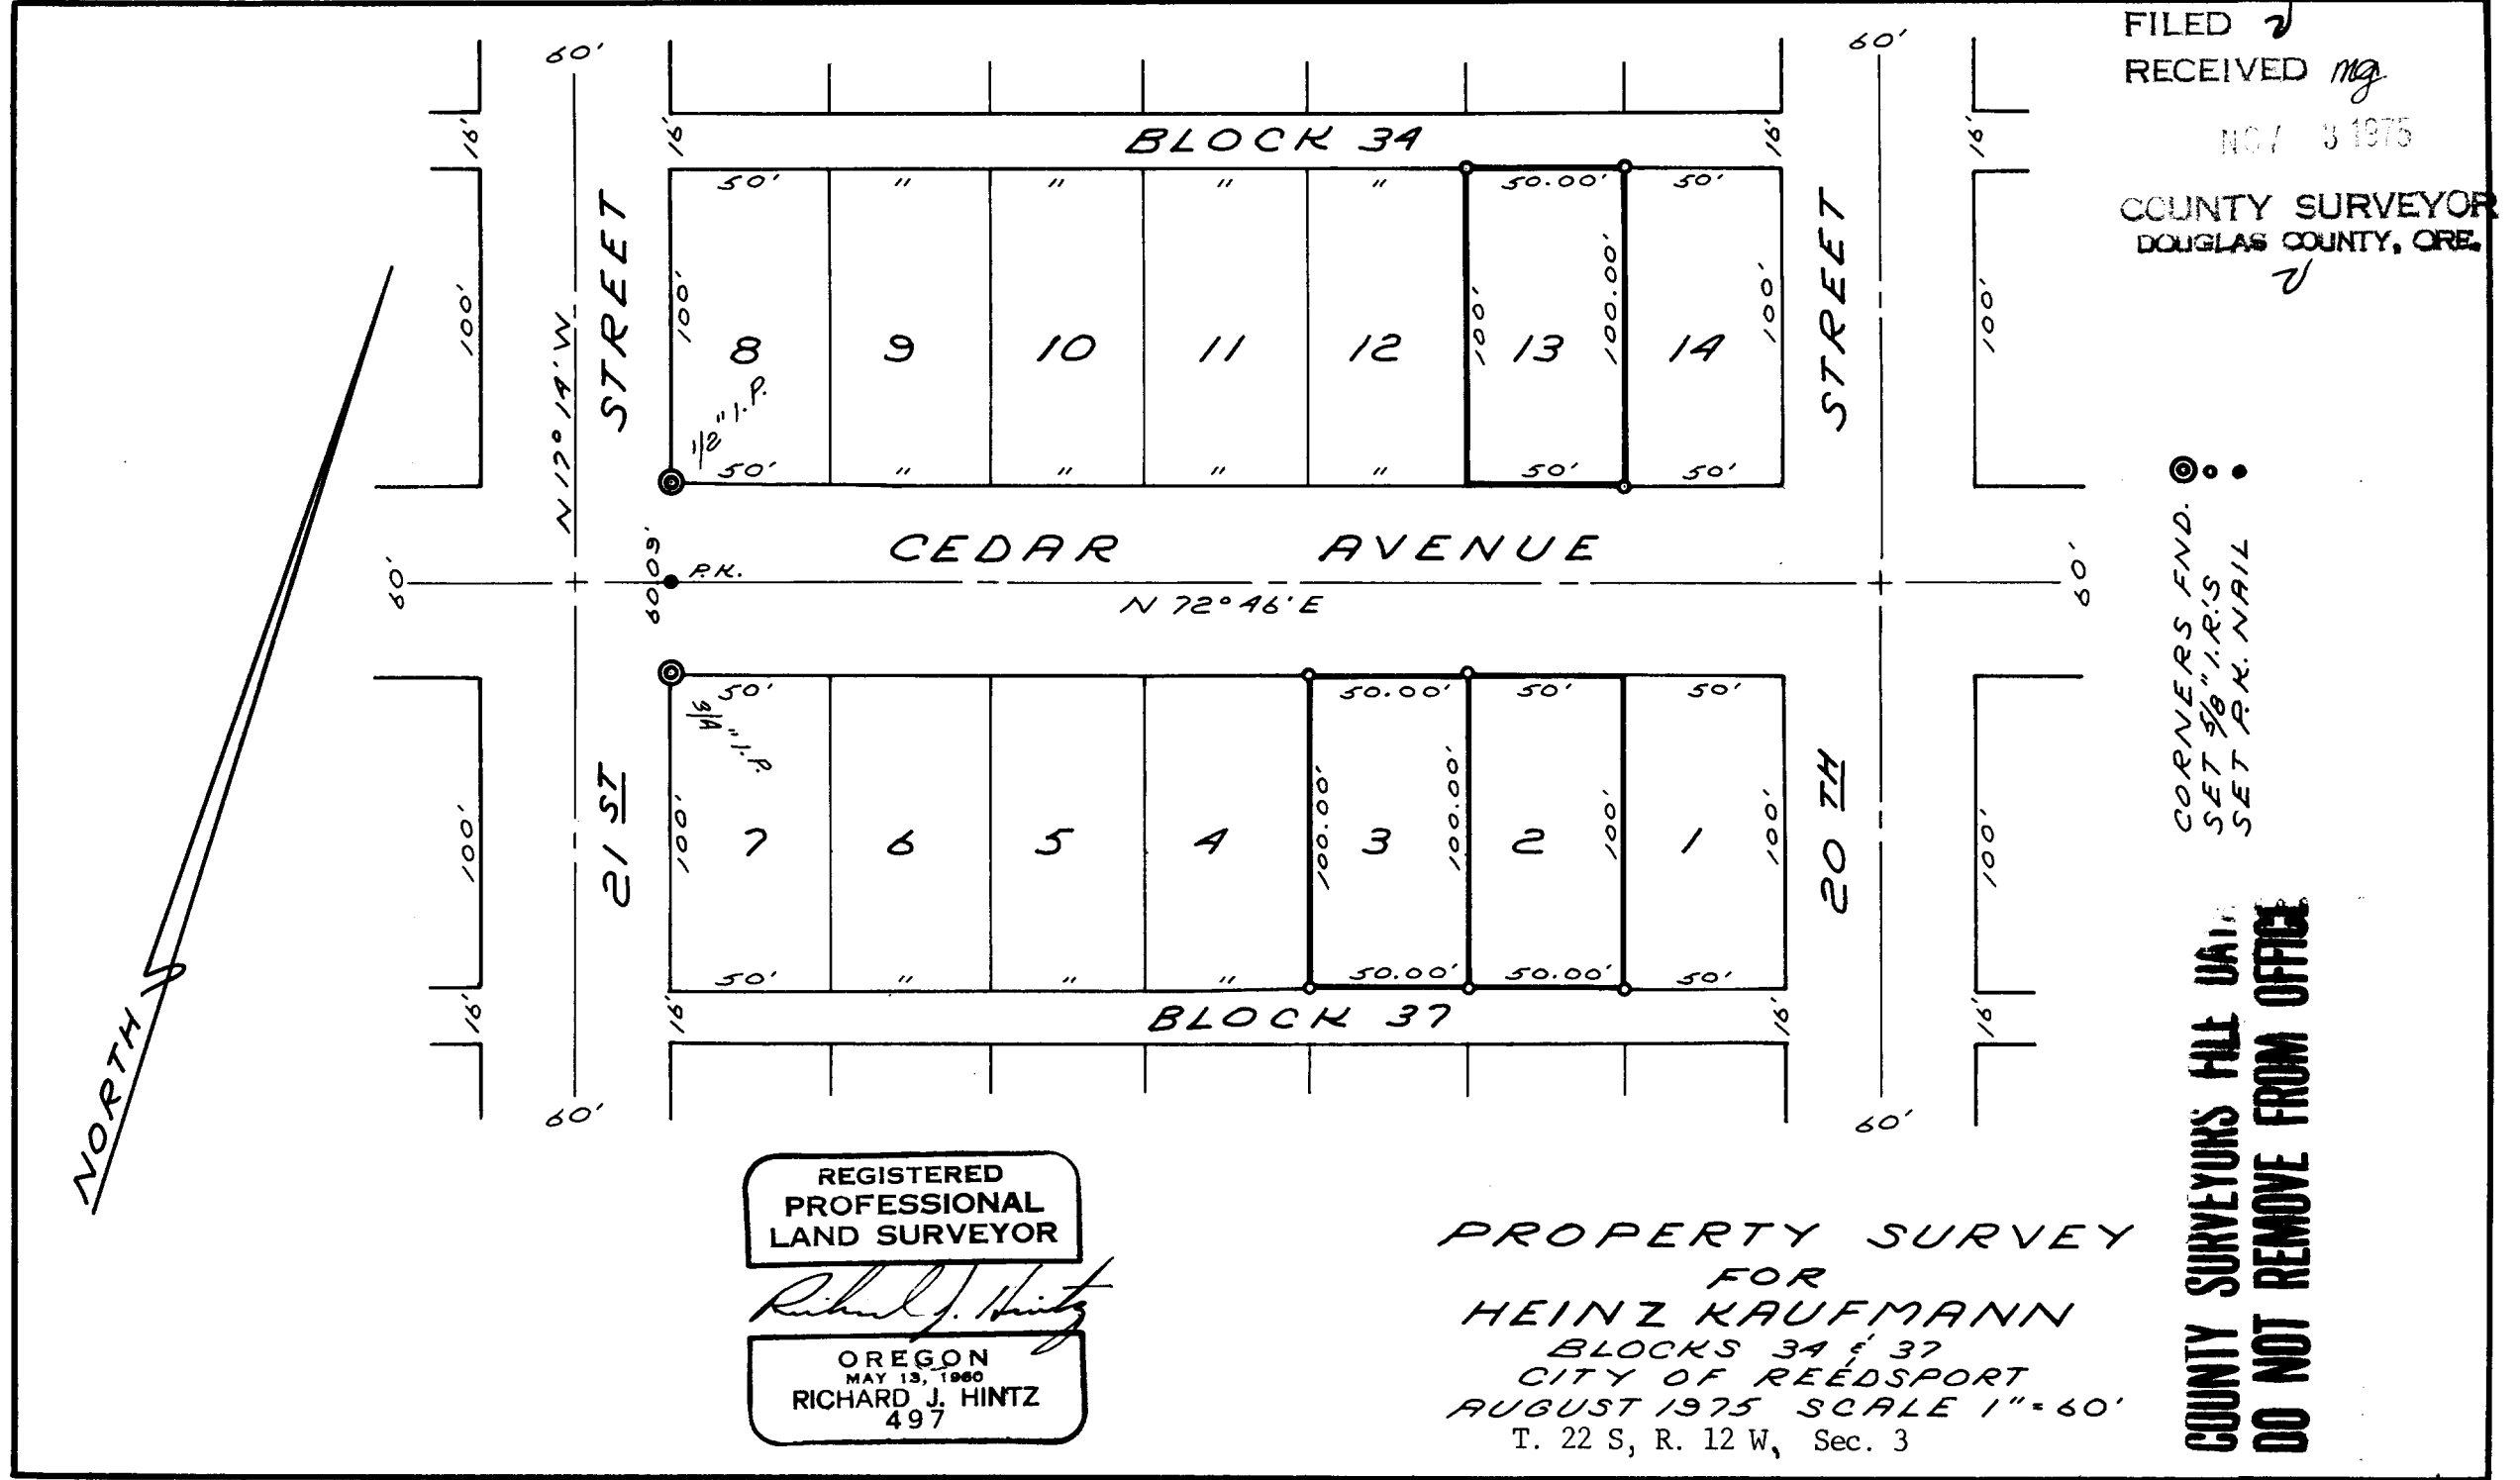

REGISTERED
PROFESSIONAL
LAND SURVEYOR

Richard J. Hintz

OREGON
MAY 13, 1960
RICHARD J. HINTZ
497

PROPERTY SURVEY
FOR
HEINZ KAUFMANN
BLOCKS 34 & 37
CITY OF REEDSPORT
AUGUST 1975 SCALE 1" = 60'
T. 22 S, R. 12 W, Sec. 3

58/73-1