

SURVEY TO SET PROPERTY COR'S IN LOT 6 BLOCK 15 BUSHEY'S ADDITION SECTION 19, T.27S.R.5W.W.M.

FOR: ORE-CON REALTY

BY: BAUGHMAN SURVEYING SERVICE

FILED
RECEIVED

SURVEYOR
JULY 14 1951
GLENN S. BAUGHMAN
536
DEER CREEK COUNTY, OREGON


OCTOBER 1975

SCALE: 1"=50'

LEGEND

- — Not set or found
- — Set 5/8" iron rod
- — Found 3/4" iron rod
- — Found 1" iron pipe

SURVEYORS FILE DATA
 DO NOT REMOVE FROM OFFICE

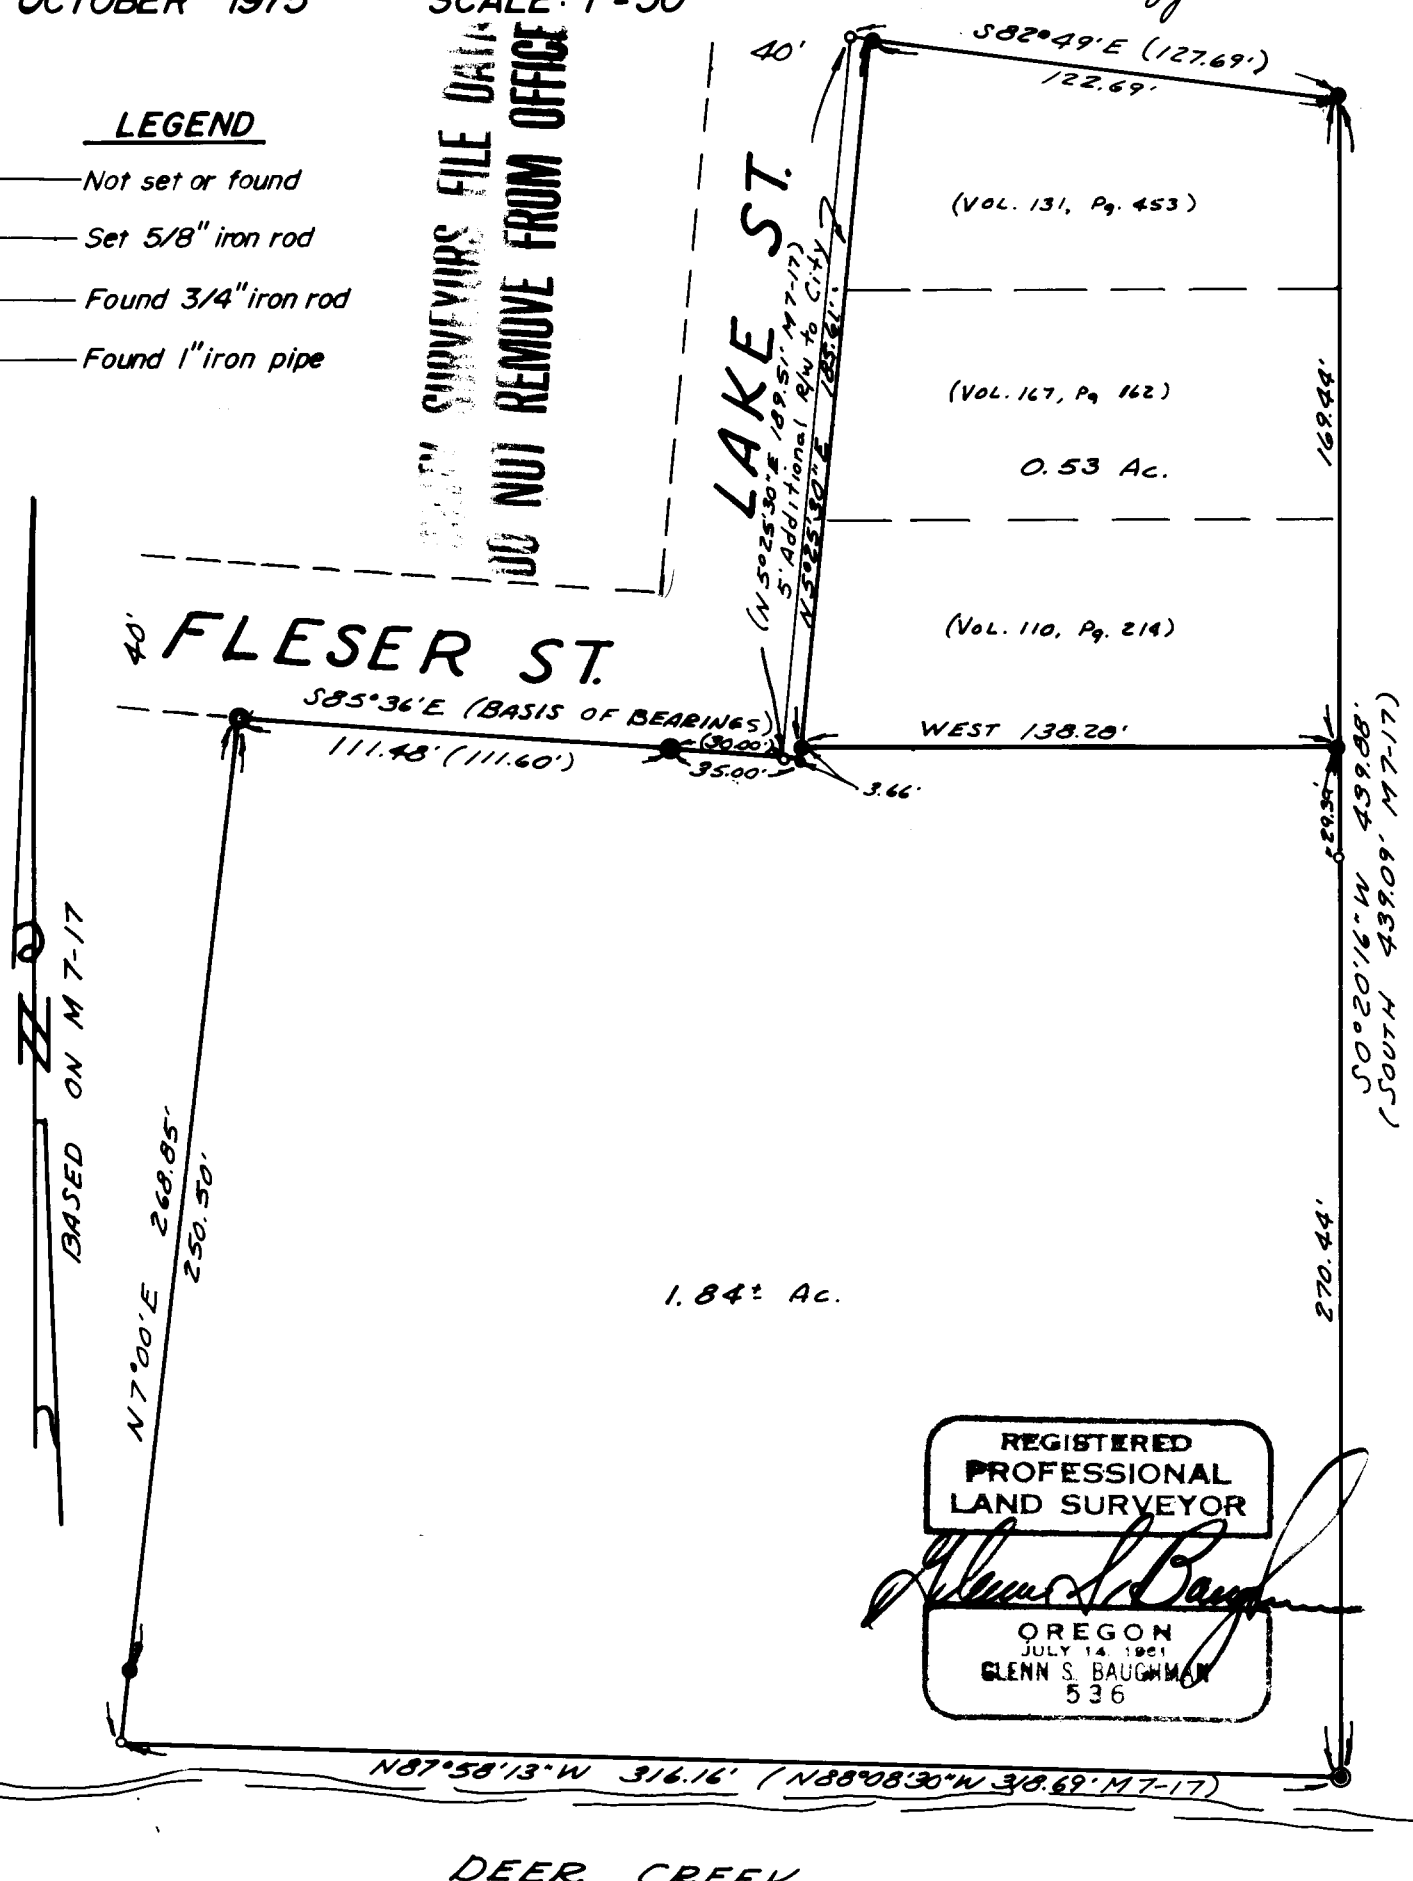

REGISTERED
PROFESSIONAL
LAND SURVEYOR

Glenn S. Baughman

OREGON
JULY 14 1951
GLENN S. BAUGHMAN
536