

COUNTY SURVEYORS FILE DATA DO NOT REMOVE FROM OFFICE

SURVEY FOR JOHN ATKINSON TO TRANSFER A PORTION
OF LOT 29 TO LOT 30, OAK KNOLLS ESTATES 1st
ADDITION ^{B.L. 2}


LOCATED IN THE SE 1/4 SEC 19, T 26S, R 5W, WM
JAN, 1976

BY HAROLD BALL CIVIL ENGINEER

FILED *mg*
RECEIVED *KU*

JAN 30 1976

COUNTY SURVEYOR
DOUGLAS COUNTY, ORE.

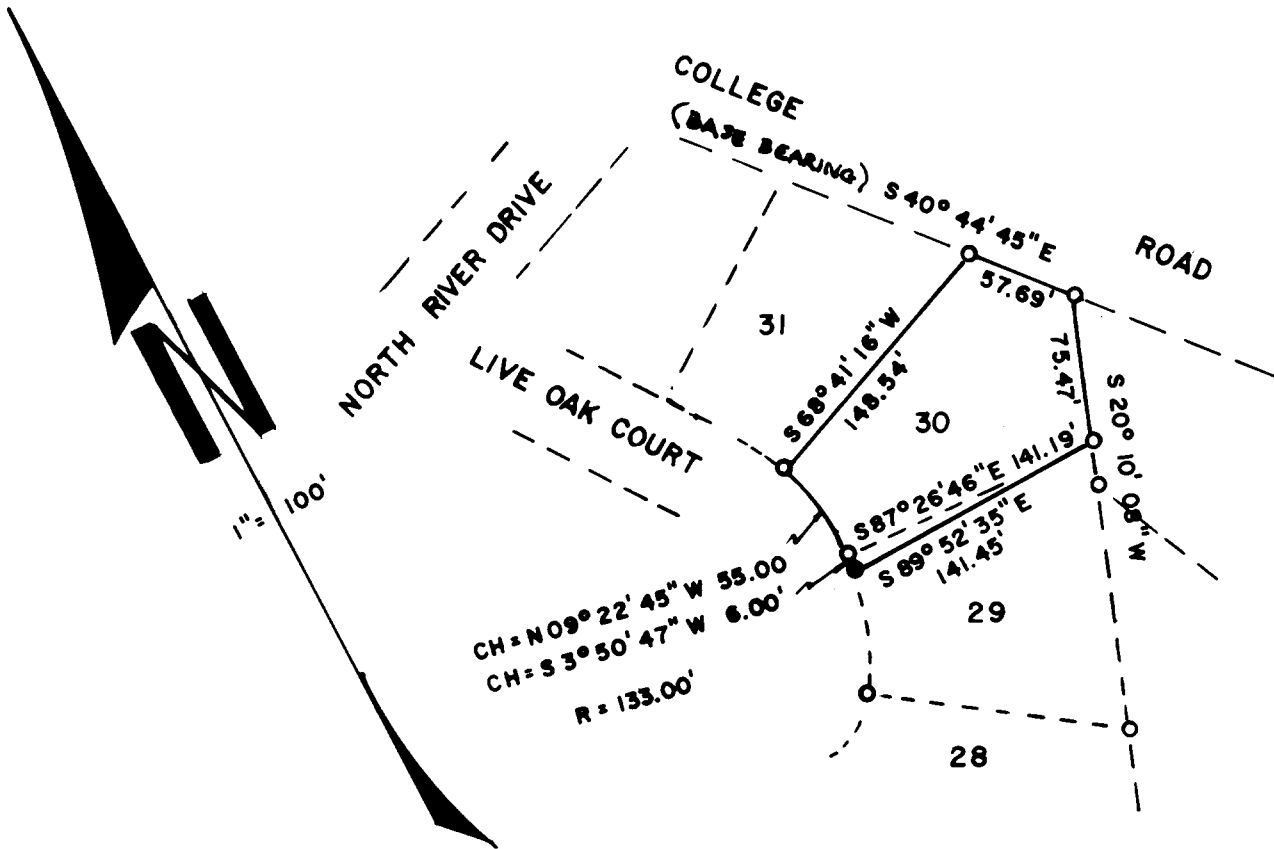

- SET 5/8" I. ROD
- FOUND 5/8" I. ROD

