


FILED 2  
RECEIVED 29

MAY 5 1976

COUNTY SURVEYOR  
DOUGLAS COUNTY, ORE.

NORTH ↖  
FND. 5/8" I.R.'S ©  
SET 5/8" I.R.'S 0

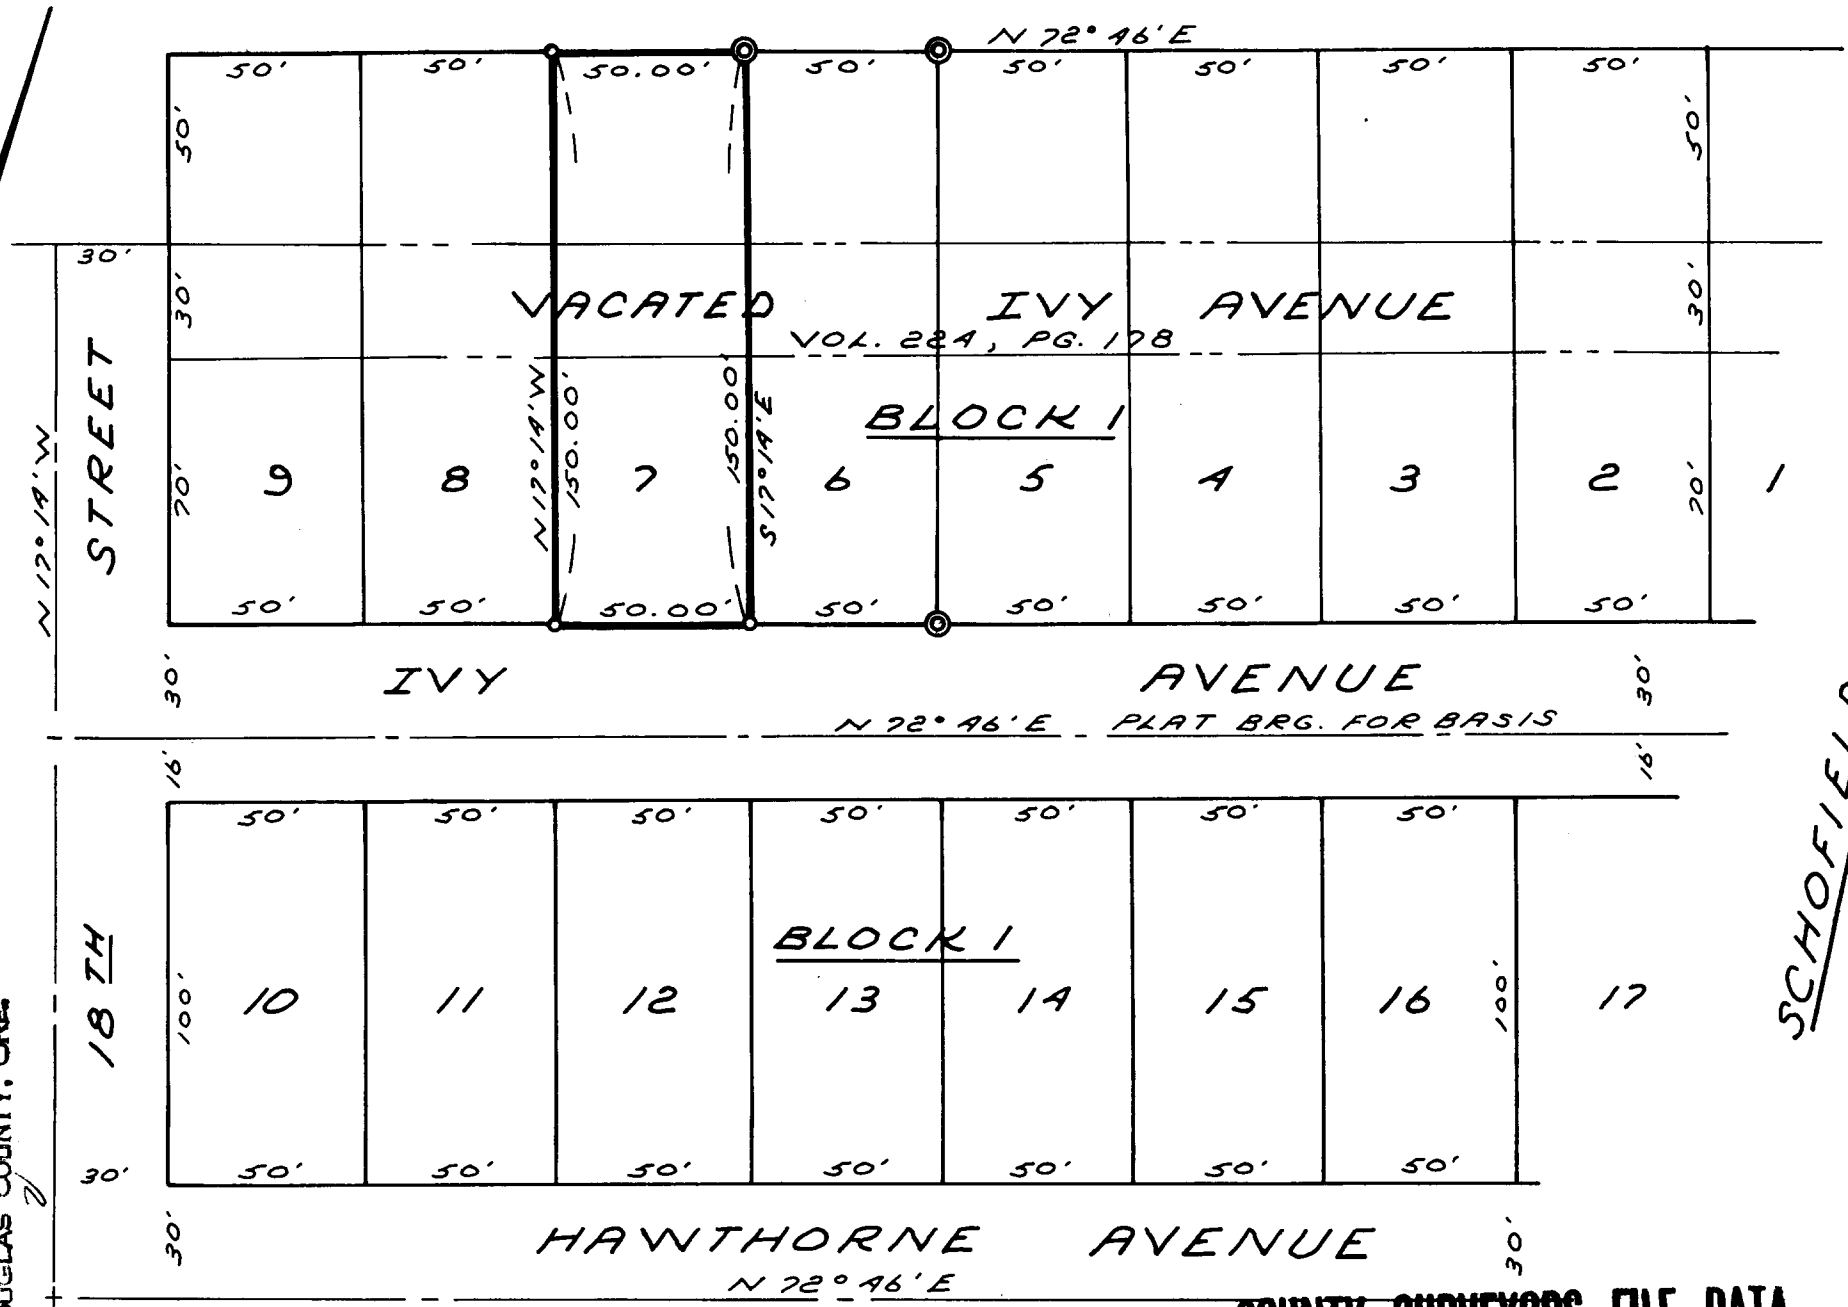

REGISTERED  
PROFESSIONAL  
LAND SURVEYOR

*Richard J. Hintz*

OREGON  
MAY 13, 1960  
RICHARD J. HINTZ  
497

PROPERTY SURVEY  
FOR  
MICHAEL KNIGHT  
LOT 7, BLOCK 1  
CITY OF REEDSPORT  
APR. 1976 SCALE 1" = 50'  
T. 21 S. R. 12 W. SEC. 34

COUNTY SURVEYORS FILE DATA  
DO NOT REMOVE FROM OFFICE