

COUNTY SURVEYORS FILE DATA
DO NOT REMOVE FROM OFFICE

FILED *mg*
RECEIVED *y*

FEB 9 1976

FIELD SURVEY
OF

OCCUPANCY
FOR

COUNTY SURVEYOR
DOUGLAS COUNTY, ORE.


JAKA M. OKORN

IN

SEC 23 & 26

T 29 S. R 5 W.

W. M.

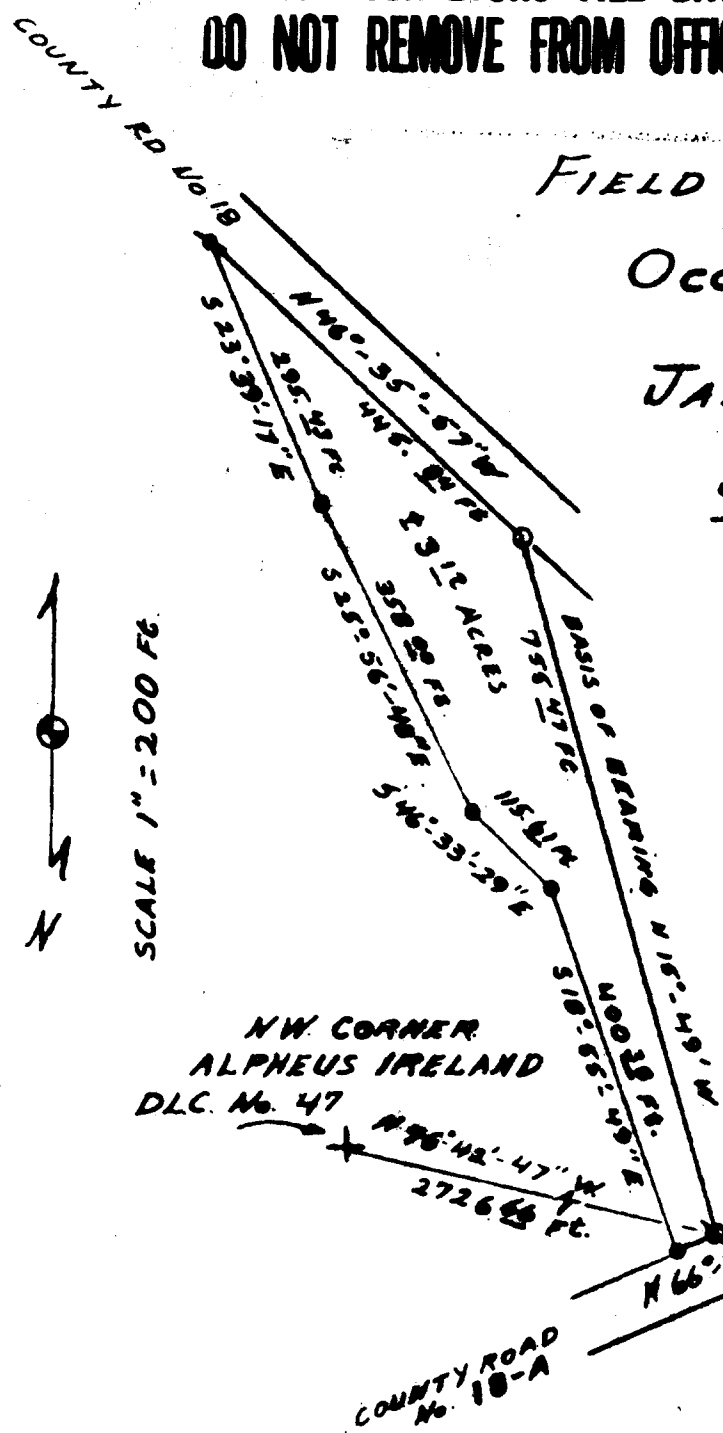

SCALE 1" = 200 FE.



BASIS OF BEARING AND
RECORD TIE FROM
MAP FILE M50-65
COUNTY SURVEYOR.

NW CORNER
ALPHEUS IRELAND
DLC No. 47

REGISTERED
OREGON
LAND SURVEYOR

William J. Murrpert

JULY 12, 1966
WILLIAM J. MURPERT
866

- ▲ FOUND 1/2" IRON ROD
- FOUND 3/4" IRON PIPE
- ◻ FOUND 1" IRON PIPE
- ◎ FOUND 1 1/4" IRON PIPE

UMBUA RESEARCH CO.
MYRTLE CREEK, OREGON

BY BILL MURPERT

JAN. 1976