

# SURVEY FOR DESCRIPTION

PLAT "A"  
IN LOTS 6 & 7, BLOCK 2, SUTHERLIN LAND & WATER CO. - SECTION 16, T.25S.R.5W.W.M.

FOR: DON EARWOOD  
BY: C & G ENG, INC.


JUNE 1977 - SCALE: 1" = 50'

FILED ✓  
RECEIVED *MS*

JUN 14 1977

COUNTY SURVEYOR  
DOUGLAS COUNTY, ORE.  
*MC*

COUNTY SURVEYORS FILE DATA  
DO NOT REMOVE FROM OFFICE

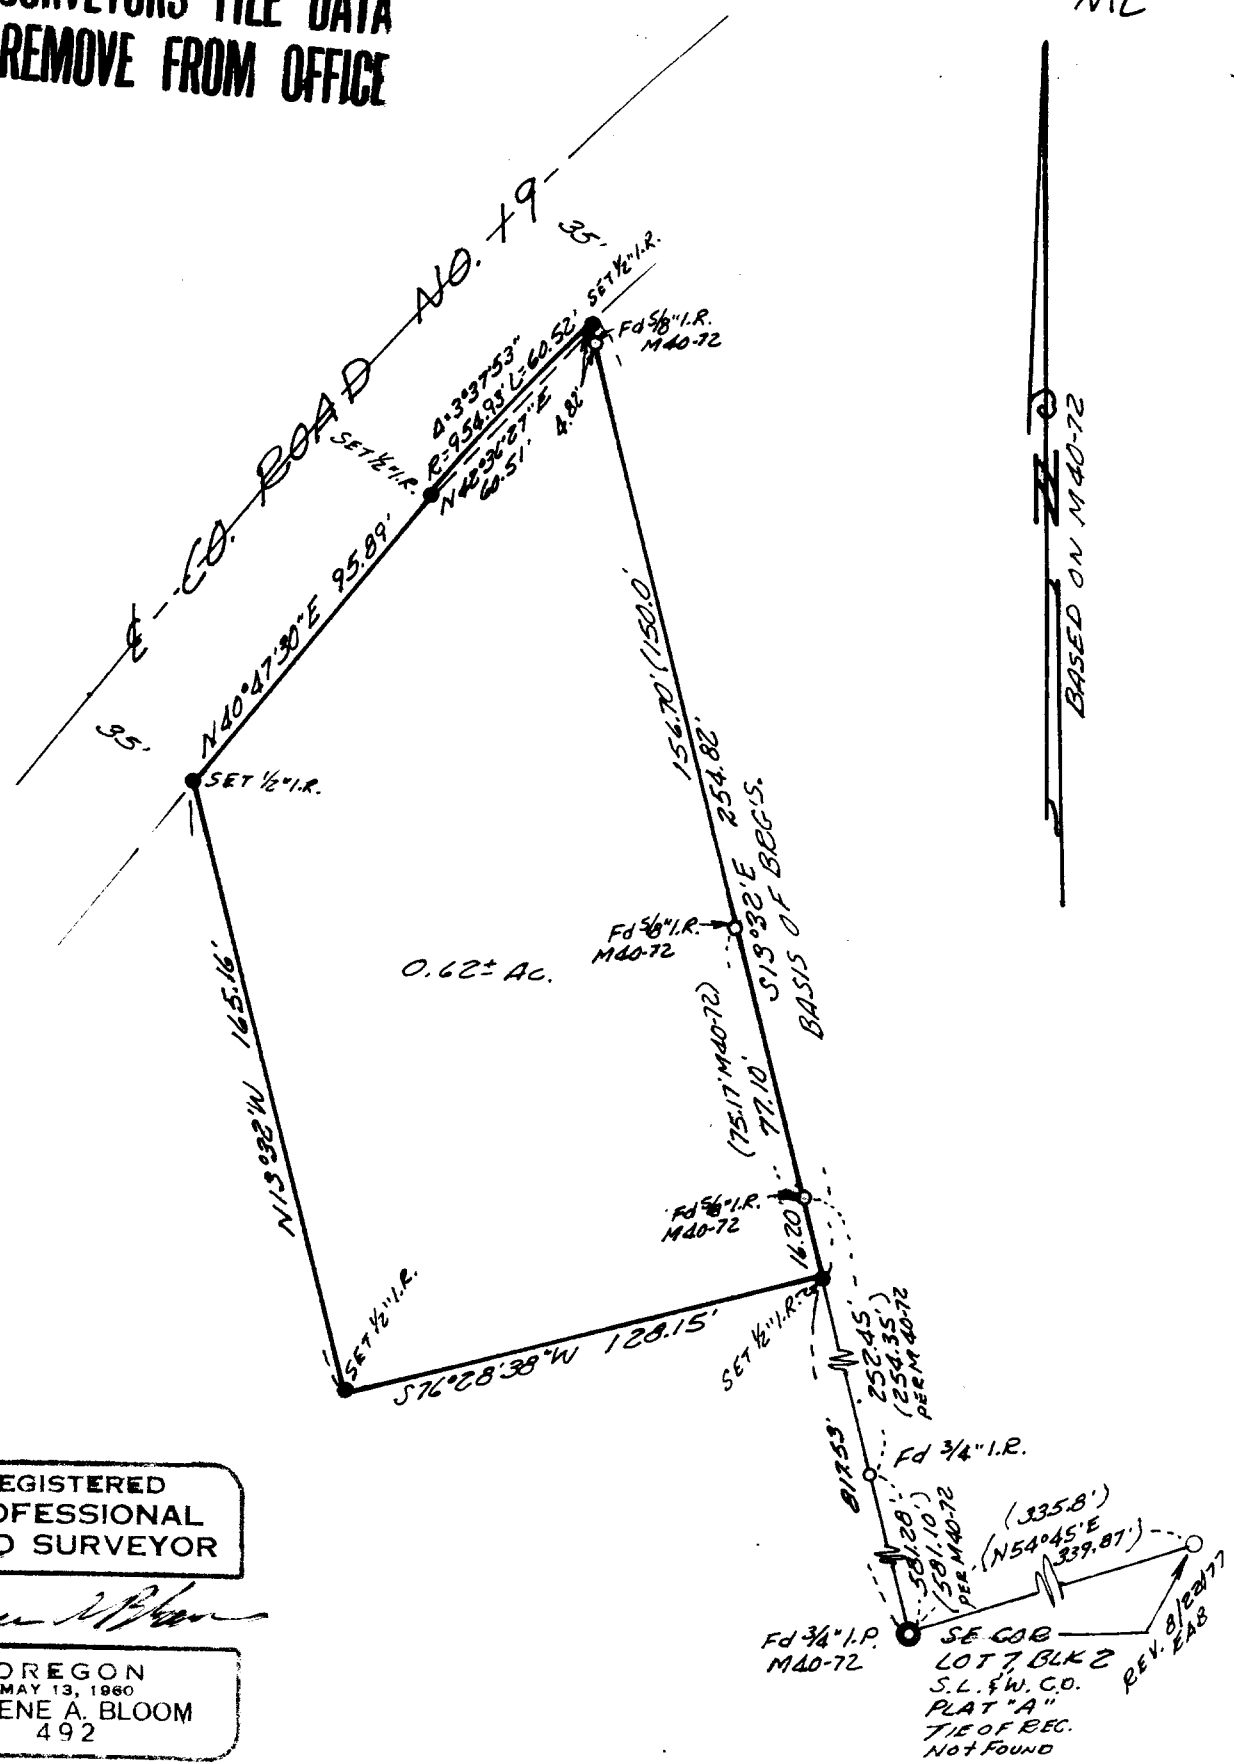

REGISTERED  
PROFESSIONAL  
LAND SURVEYOR

*Eugene A. Bloom*

OREGON  
MAY 13, 1960  
EUGENE A. BLOOM  
492

6140.0000-55