

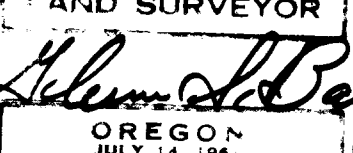
SURVEY TO SET PROPERTY CORNERS

LOTS 10, 11, 12, BLOCK 1, GOURLEY'S ADDITION
 IN SECTION 20, T.25S.R.5W.W.M.-SUTHERLIN, ORE.

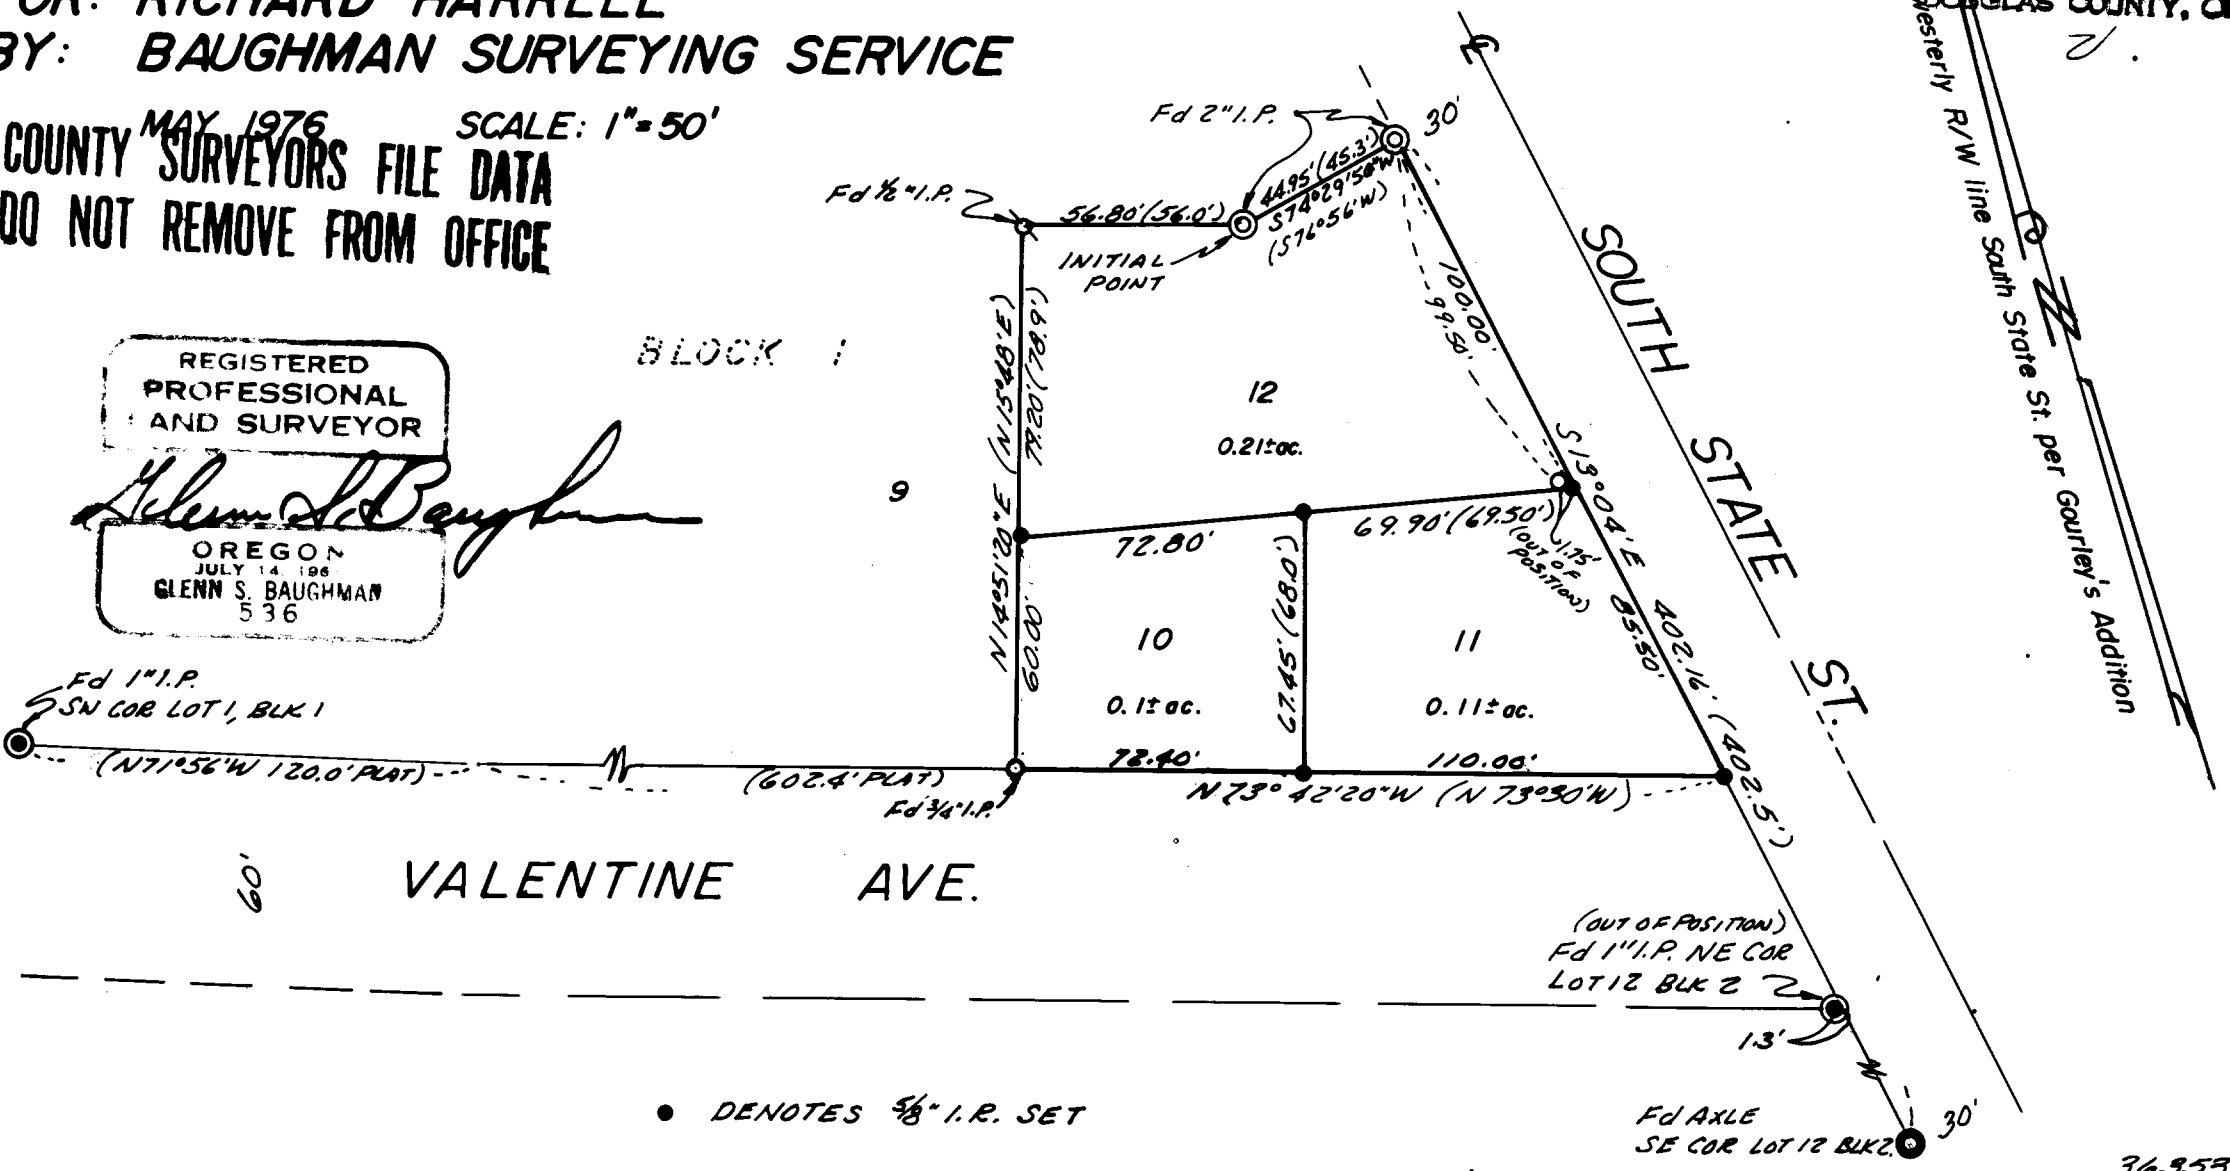
FOR: RICHARD HARRELL
 BY: BAUGHMAN SURVEYING SERVICE

FILED
 RECEIVED
 MAY 24 1976
 COUNTY SURVEYOR
 DOUGLAS COUNTY, ORE.

MAY 1976 SCALE: 1" = 50'
 COUNTY SURVEYORS FILE DATA
 DO NOT REMOVE FROM OFFICE

REGISTERED
 PROFESSIONAL
 AND SURVEYOR

 OREGON
 JULY 14, 1966
 GLENN S. BAUGHMAN
 536

BLOCK 1



• DENOTES 5/8" I.P. SET

36953
 REVISED 5/11/76
 C.S. File No. 58/100-3