

FILED *v*
RECEIVED *dh*
FEB 22 1979


COUNTY SURVEYOR
DOUGLAS COUNTY, ORE.
TS

SCALE: 1" = 50'
DATE: JAN. 2, 1979




30.3' 45.4' 50' 50' 50'

SECOND STREET

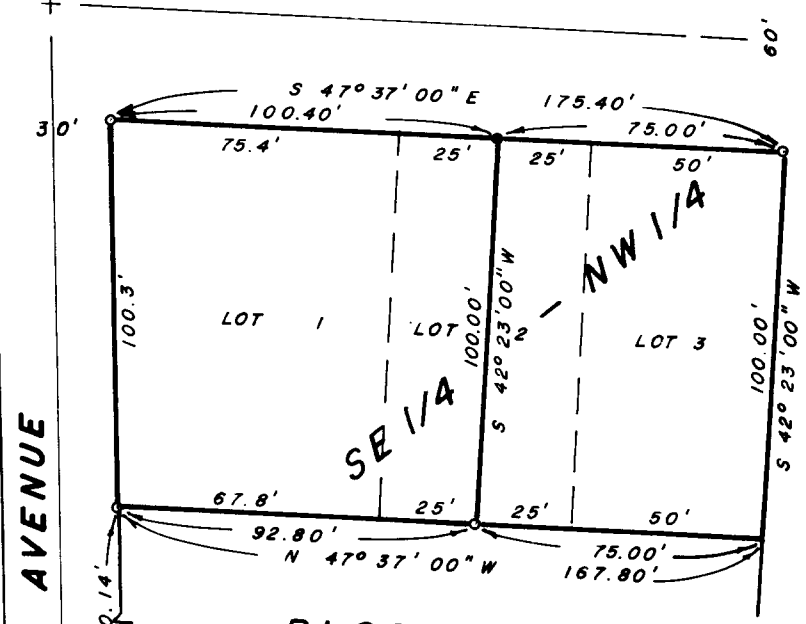

BLOCK 46

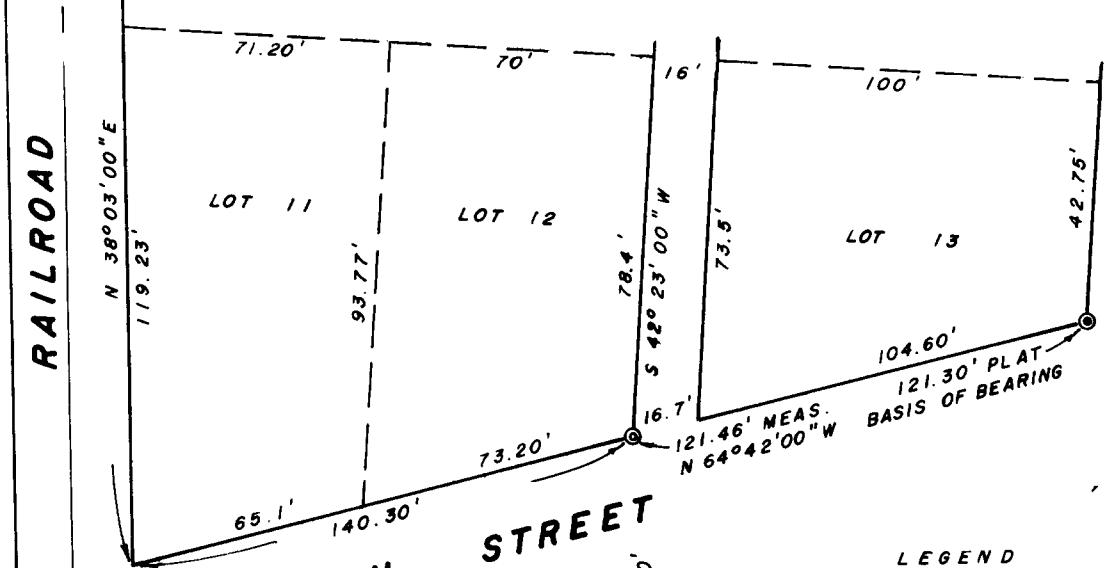

FOURTH STREET

LEGEND

- ⊙ FOUND MONUMENT
- SET 5/8" IRON ROD
- SET NAIL AND FLASHER

PROPERTY SURVEY

A PORTION OF THE SE 1/4 OF THE NW 1/4 OF SECTION 35, TOWNSHIP 21 SOUTH, RANGE 12 WEST, W.M., TRACT A - LOT 1 & THE WEST 1/2 OF LOT 2, BLOCK 46, TRACT B - LOT 3 & THE EAST 1/2 OF LOT 2, BLOCK 46, AMENDED PLAT OF RAILROAD ADDITION, REEDSPORT, DOUGLAS COUNTY, OREGON

FOR THE CITY OF REEDSPORT
451 WINCHESTER AVENUE
REEDSPORT, OREGON

Forest H. Stale

COUNTY SURVEYORS FILE DATA
DO NOT REMOVE FROM OFFICE

HCE ENGINEERS & PLANNERS
405 N. FIFTH/C009 BAY, OR 97420
19 N. W. 5th/PORTLAND, OR 97209

C. S. File No. 58/104-5