

HANTHORNE

10TH STREET

BLOCK 5L

REGISTERED PROFESSIONAL LAND SURVEYOR

*Warren D. Hootman*


OREGON  
MAY 18, 1957  
WARREN D. HOOTMAN  
399

COUNTY SURVEYORS FILE DATA  
DO NOT REMOVE FROM OFFICE


T. 21 S. R. 12 W SEC. 34  
SURVEY OF LOTS 1, 2, 3 & THE EASTERLY  
20' OF LOT 4, BLOCK 3, RAINBOW  
ADDITION #2, REEDSPORT, DOUGLAS CO. OREGON

for: PATRICK J. ROELLE

Corners found:   
Corners set:   
Scale: 1" = 50'  
April 16, 1976

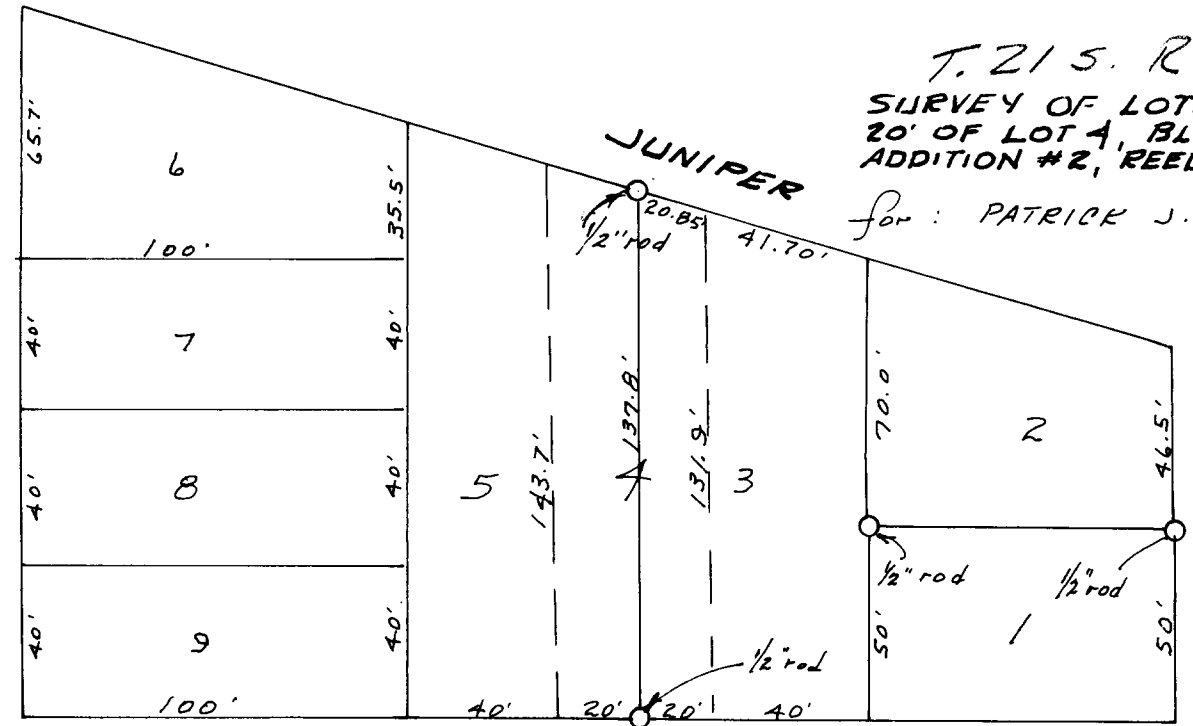

BLOCK 3

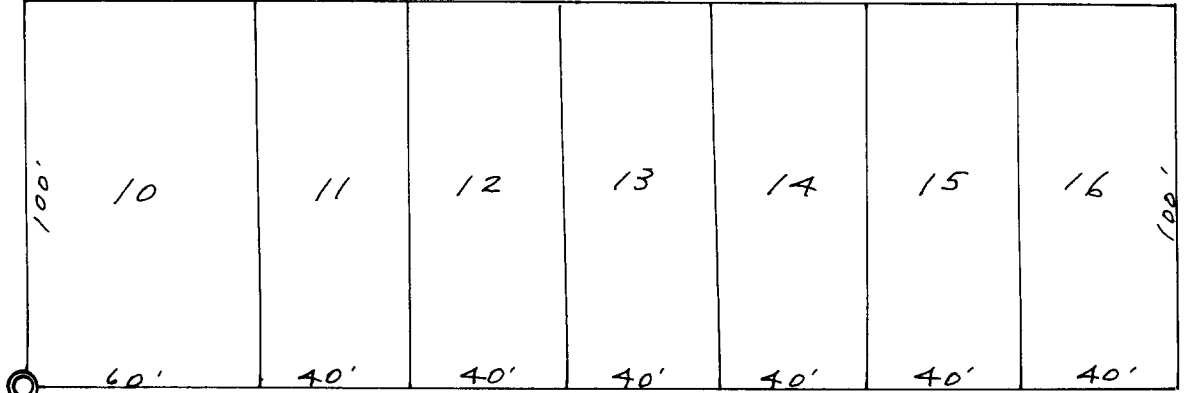

(N 70° 18' W)  
Deed

GREENWOOD

9TH STREET

FILED   
RECEIVED

JUN 14 1976

COUNTY SURVEYOR  
DOUGLAS COUNTY, ORE.