


FILED

RECEIVED


JUL 19 1976

COUNTY SURVEYOR
DOUGLAS COUNTY, ORE.

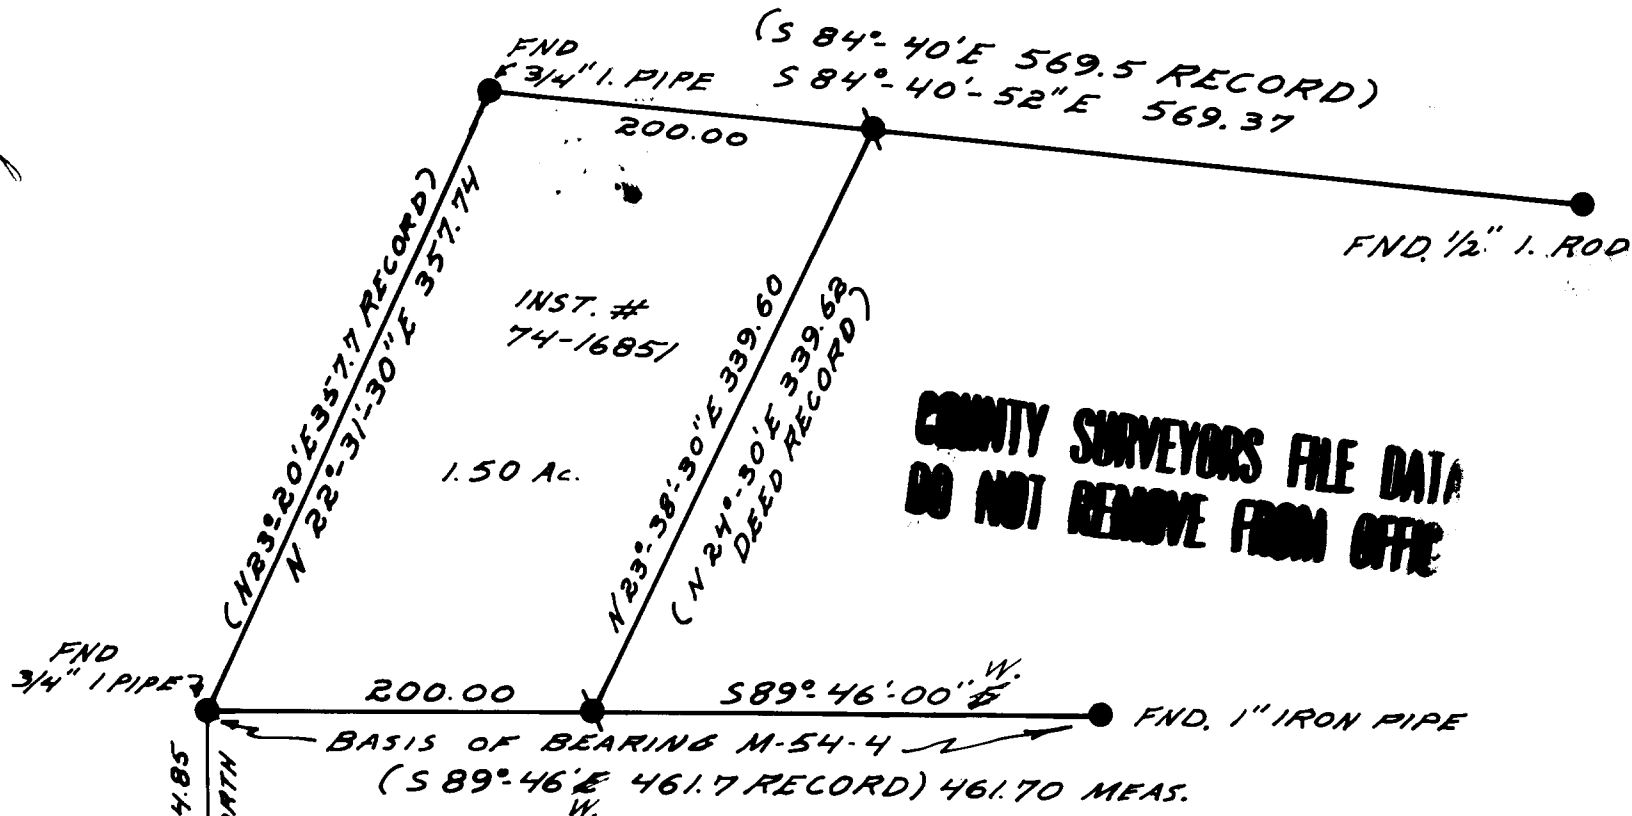

INST. #
74-16851
1.50 Ac.

**COUNTY SURVEYORS FILE DATA
DO NOT REMOVE FROM OFFICE**

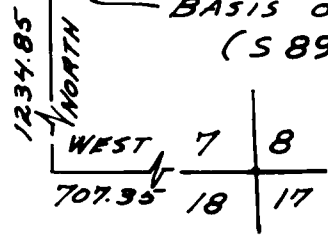

RECORD TIE
M-54-4

LEGEND

- SET 5/8 I. ROD
- FOUND MONUMENT PER M-54-4

REGISTERED
OREGON
LAND SURVEYOR

William J. Ruppert

JULY 12, 1968
WILLIAM J. RUPPERT
866

FIELD SURVEY
FOR
DARRYL LA BECK
SECTION 7 T.30 S. R.5. W. W.M.

UMPQUA RESEARCH COMPANY
MYRTLE CREEK, OREGON
JULY 1976

NORTH
BASIS OF BEARING
M-54-4
1" = 100'

C. S. File No. 58/110-2

C. S. File No. 58/110-2