

FIELD SURVEY
FOR
VALERE E. BRANDT
SEC. 34 T.30S. R.5W. WM.

UMPOVA RESEARCH CO.
MYRTLE CREEK, OREGON
JULY 1976

COUNTY SURVEYORS FILE DATA
DO NOT REMOVE FROM OFFICE

FILED ✓
RECEIVED *RLS*

JUL 19 1976

COUNTY SURVEYOR
DOUGLAS COUNTY, ORE.
✓


LEGEND

- SET 5/8" IRON ROD
- FOUND MONUMENT PER M-50-36
- ⊙ POINT PER DEED INST No. 75-11570

REGISTERED
OREGON
LAND SURVEYOR

William J. Ruppert

JULY 12, 1968
WILLIAM J. RUPPERT
866

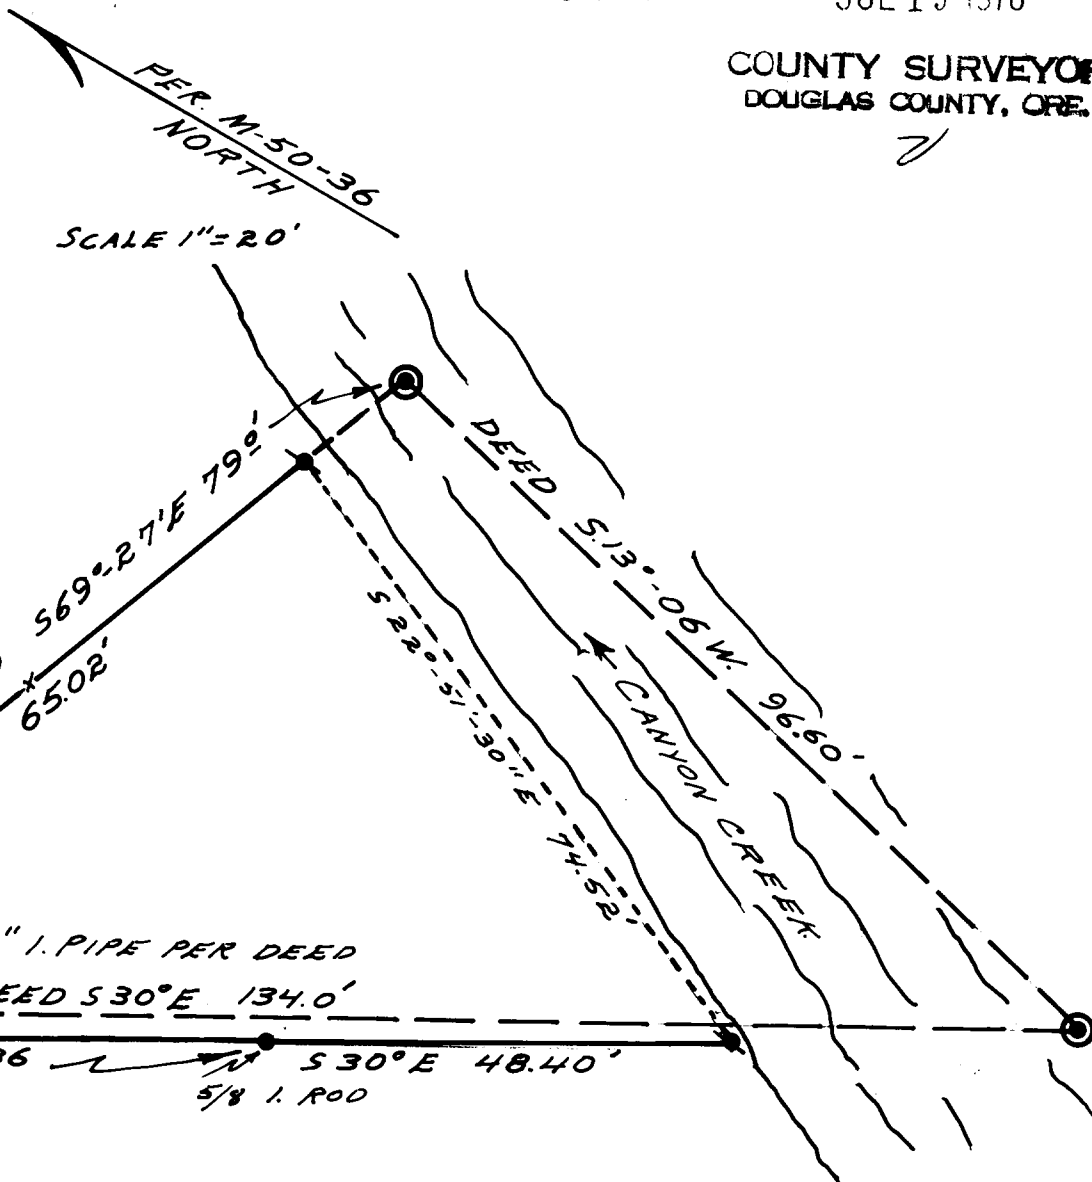

SOUTHWESTERLY CORNER.
LOT 8 BLOCK 7 CITY OF
CANYONVILLE - PER M-50-36