


COUNTY SURVEYORS FILE DATA  
DO NOT REMOVE FROM OFFICE

FILED ✓  
RECEIVED ✓

OCT 26 1976

COUNTY SURVEYOR  
DOUGLAS COUNTY, ORE.

LOON LAKE

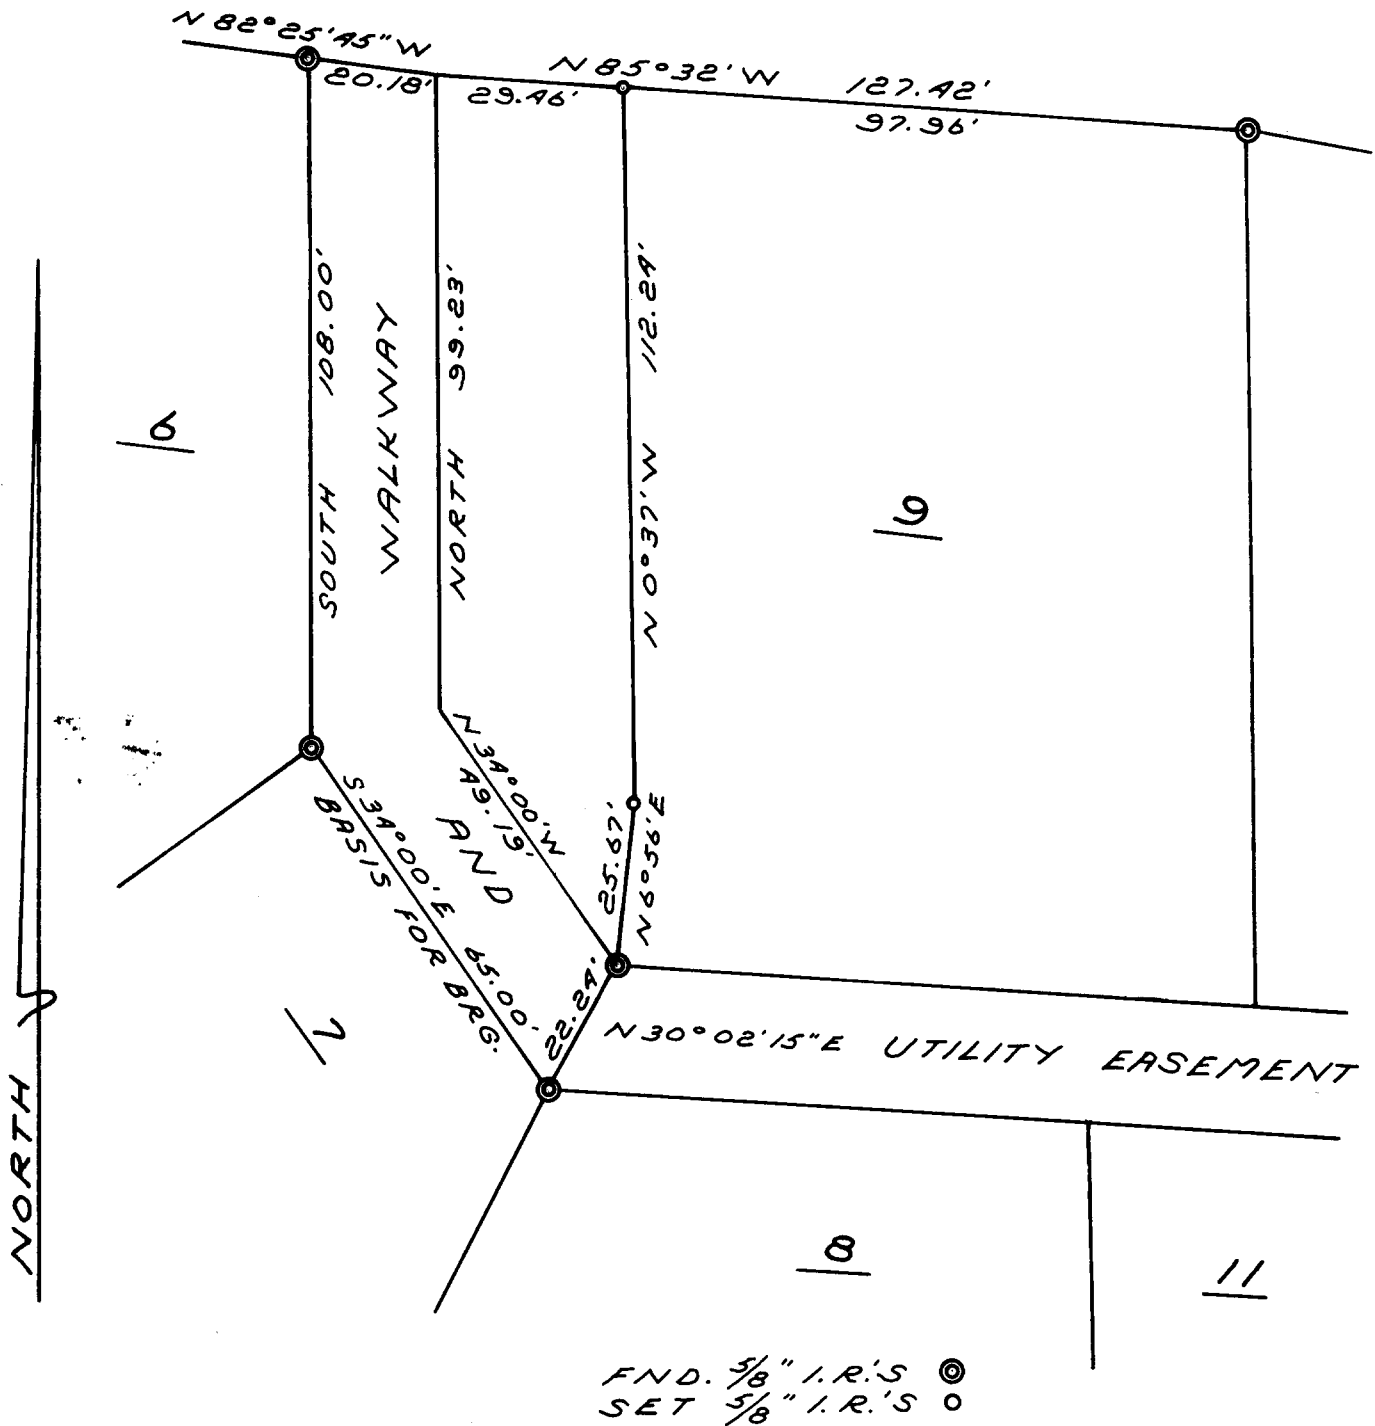

REGISTERED  
PROFESSIONAL  
LAND SURVEYOR

*Richard J. Hintz*

OREGON  
MAY 13, 1980  
RICHARD J. HINTZ  
497

PROPERTY SURVEY  
FOR  
STEVE PEPIOT  
PORTION OF LOT 9  
SUMMER HAVEN ESTATES  
W 1/2 W 1/2, SEC. 12, T23S, R10 W  
SEPT. 1976 SCALE: 1" = 30'