


FILED
RECEIVED

AUG 29 1977

COUNTY SURVEYOR
DOUGLAS COUNTY, ORE.

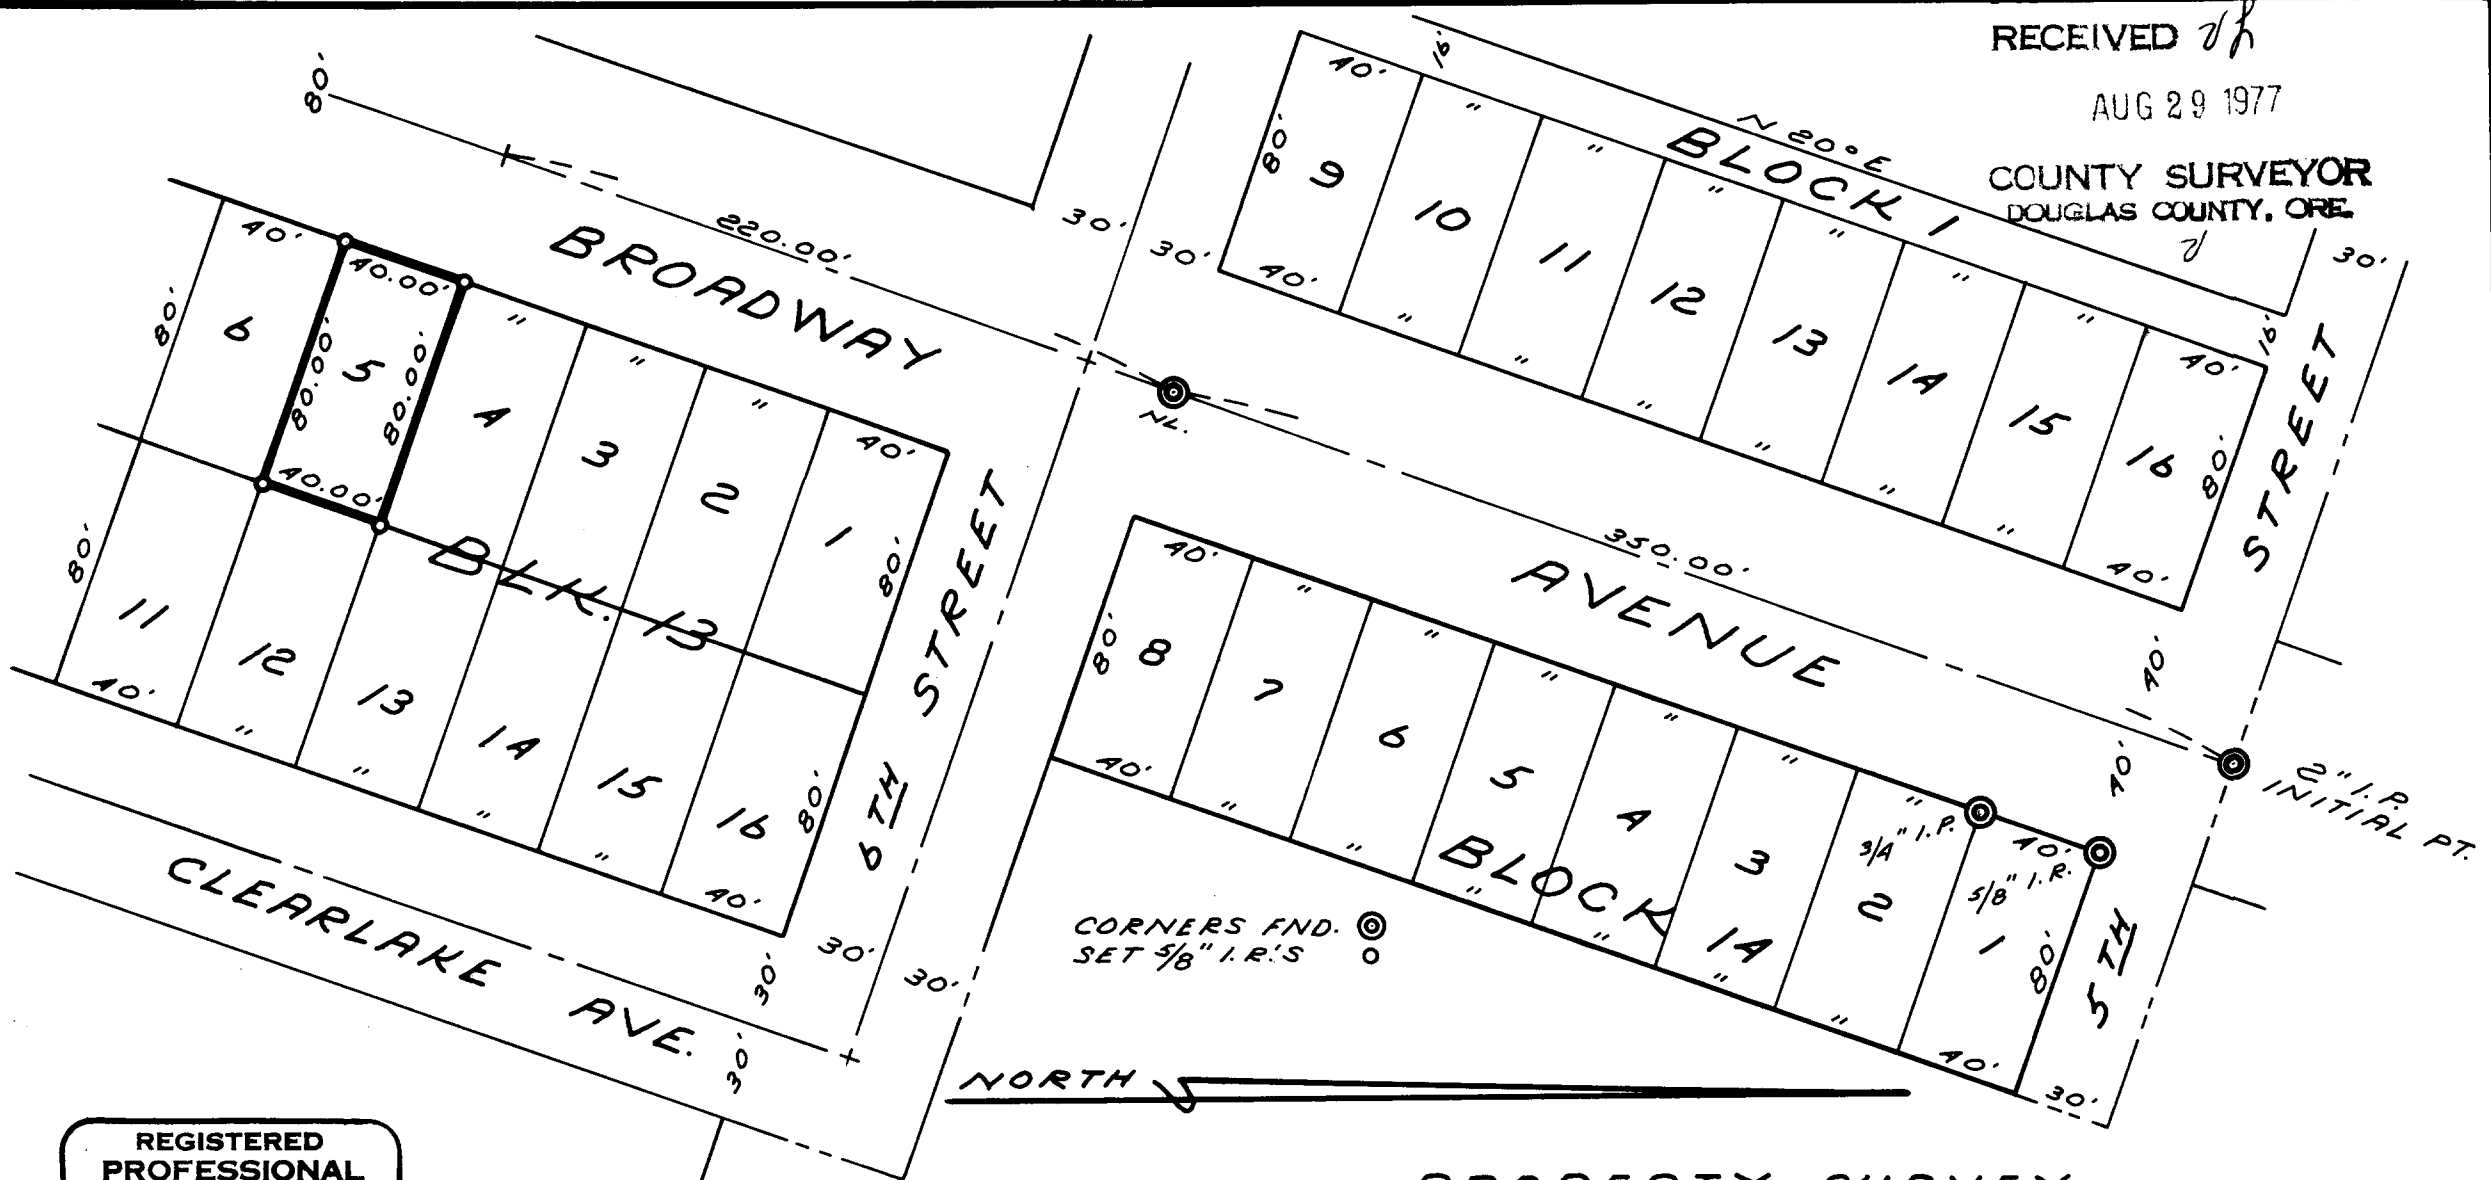

REGISTERED
PROFESSIONAL
LAND SURVEYOR

Richard J. Hintz

OREGON
MAY 13, 1960
RICHARD J. HINTZ
497

**COUNTY SURVEYORS FILE DATA
DO NOT REMOVE FROM OFFICE**

PROPERTY SURVEY
FOR
MRS. VIRGINIA BOYD
LOT 5, BLOCK 13
WINCHESTER BAY
AUGUST 1977, SCALE 1"=60'
T 22 - 12 SEC. 7

C.S. File No. 58/121-5