

SURVEY TO SET PROPERTY CORNERS

LOT 22 BLOCK 5 GARDEN HOMES

SECTION 14 T.27S. R.6W.W.M.

FOR: FRED EARWOOD — BY: C & G ENG. INC.

OCTOBER 1976 — SCALE: 1" = 50'

FILED ✓
RECEIVED ✓

NOV 9 1976



COUNTY SURVEYOR
DOUGLAS COUNTY, ORE.

COUNTY SURVEYORS FILE DATA
DO NOT REMOVE FROM OFFICE

REGISTERED
PROFESSIONAL
AND SURVEYOR

Glenn H. Baughman

OREGON
JULY 4 1966
GLENN H. BAUGHMAN
536

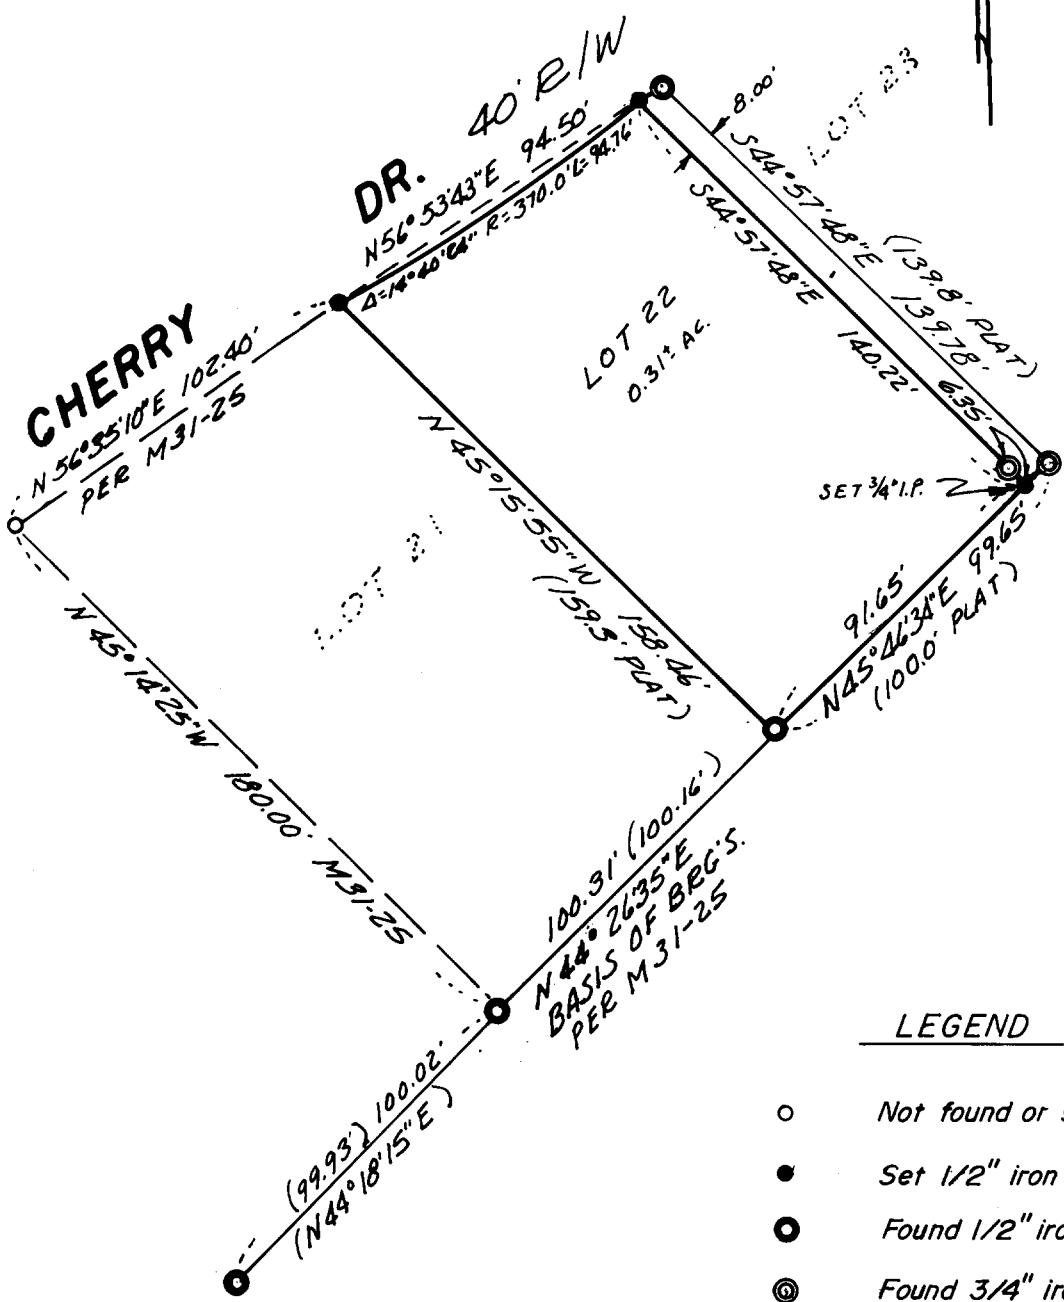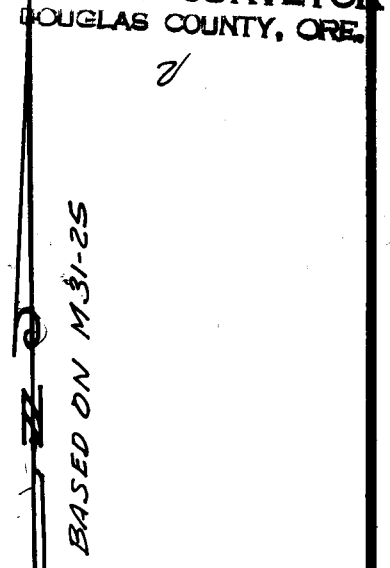

LEGEND

- Not found or set
- Set 1/2" iron rod
- ⊙ Found 1/2" iron pipe
- ⊙ Found 3/4" iron pipe

36-619