

SURVEY TO SET PROPERTY CORNERS - SEC. 28, T.29S. R.5W. W.M.

FOR: LOUIS HAGBERG - BY: C & G ENG, INC.

FEBRUARY 1977


SCALE: 1" = 40'

**COUNTY SURVEYORS FILE DATA
DO NOT REMOVE FROM OFFICE**

RECEIVED
FEB 17 1977

COUNTY SURVEYOR
DOUGLAS COUNTY, ORE.
Found - per M55-16

SW cor Lazarus Wright
DLC No. 45 T29SR5W.WM.

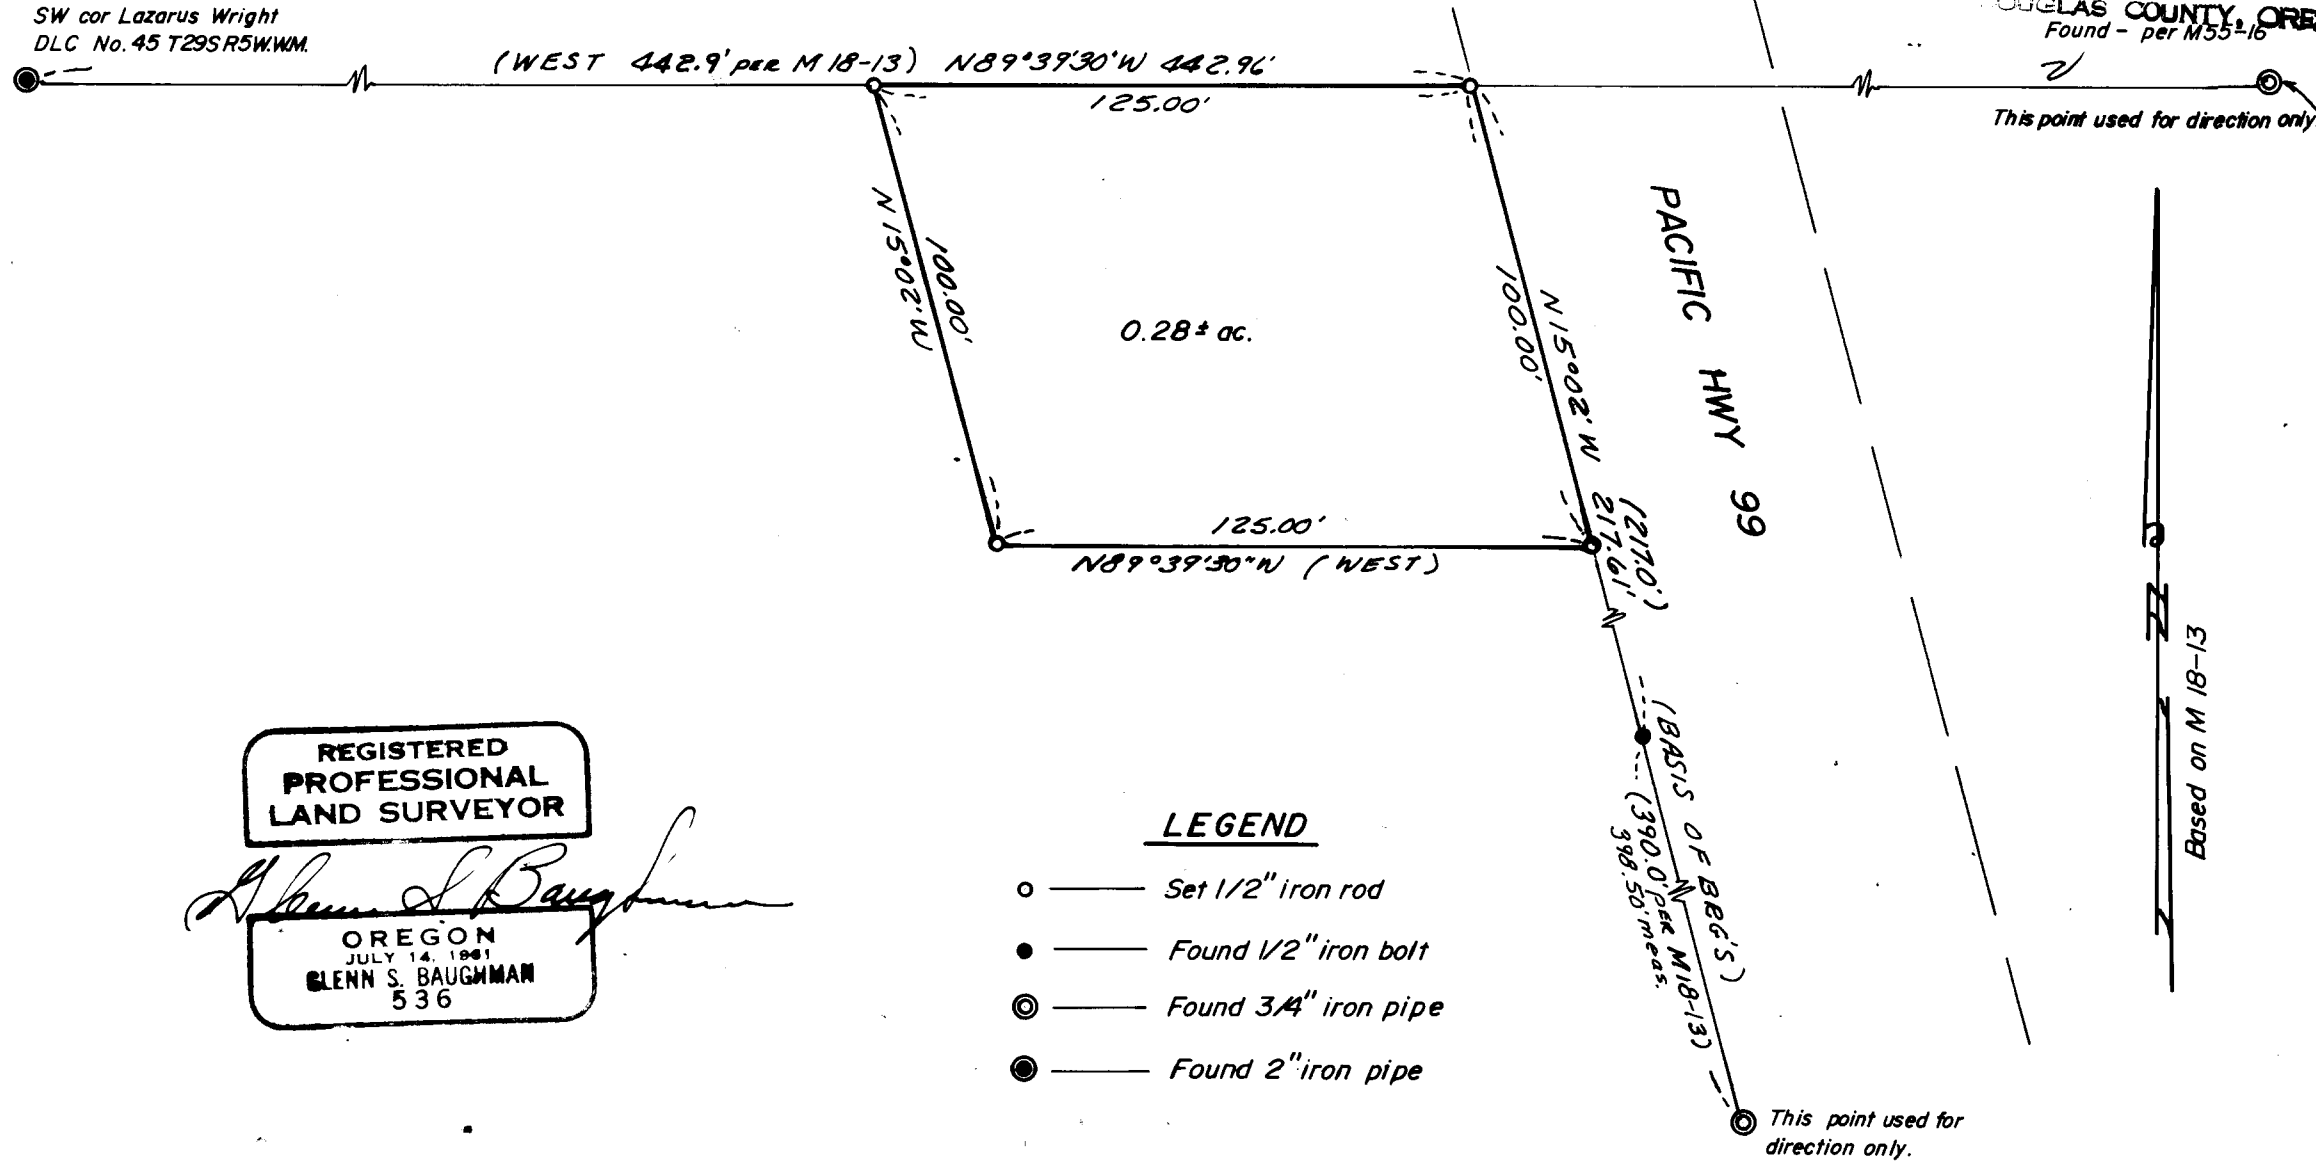

REGISTERED
PROFESSIONAL
LAND SURVEYOR

Glenn S. Baughman

OREGON
JULY 14, 1961
GLENN S. BAUGHMAN
536

LEGEND

- — Set 1/2" iron rod
- — Found 1/2" iron bolt
- ⊙ — Found 3/4" iron pipe
- ⦿ — Found 2" iron pipe

6140.0026

C. S. File No. 58/131-3