

SURVEY OF LOT 14, "EDENBOWER ORCHARD TRACT," VOL. 4, PAGE 56,

SEC. 1, T27S, R6W, W.M.

SURVEY FOR JOHN BALLEW

SURVEY BY BHW ENG & SURVEYING, INC.

COUNTY SURVEYORS FILE DATA
DO NOT REMOVE FROM OFFICE

FILED
RECEIVED *ry*


FEB 16 1977

COUNTY SURVEYOR
DOUGLAS COUNTY, ORE.

○ - SET 5/8" IRON ROD
● - FOUND MONUMENTS

FEB., 1977

SCALE: 1" = 200'

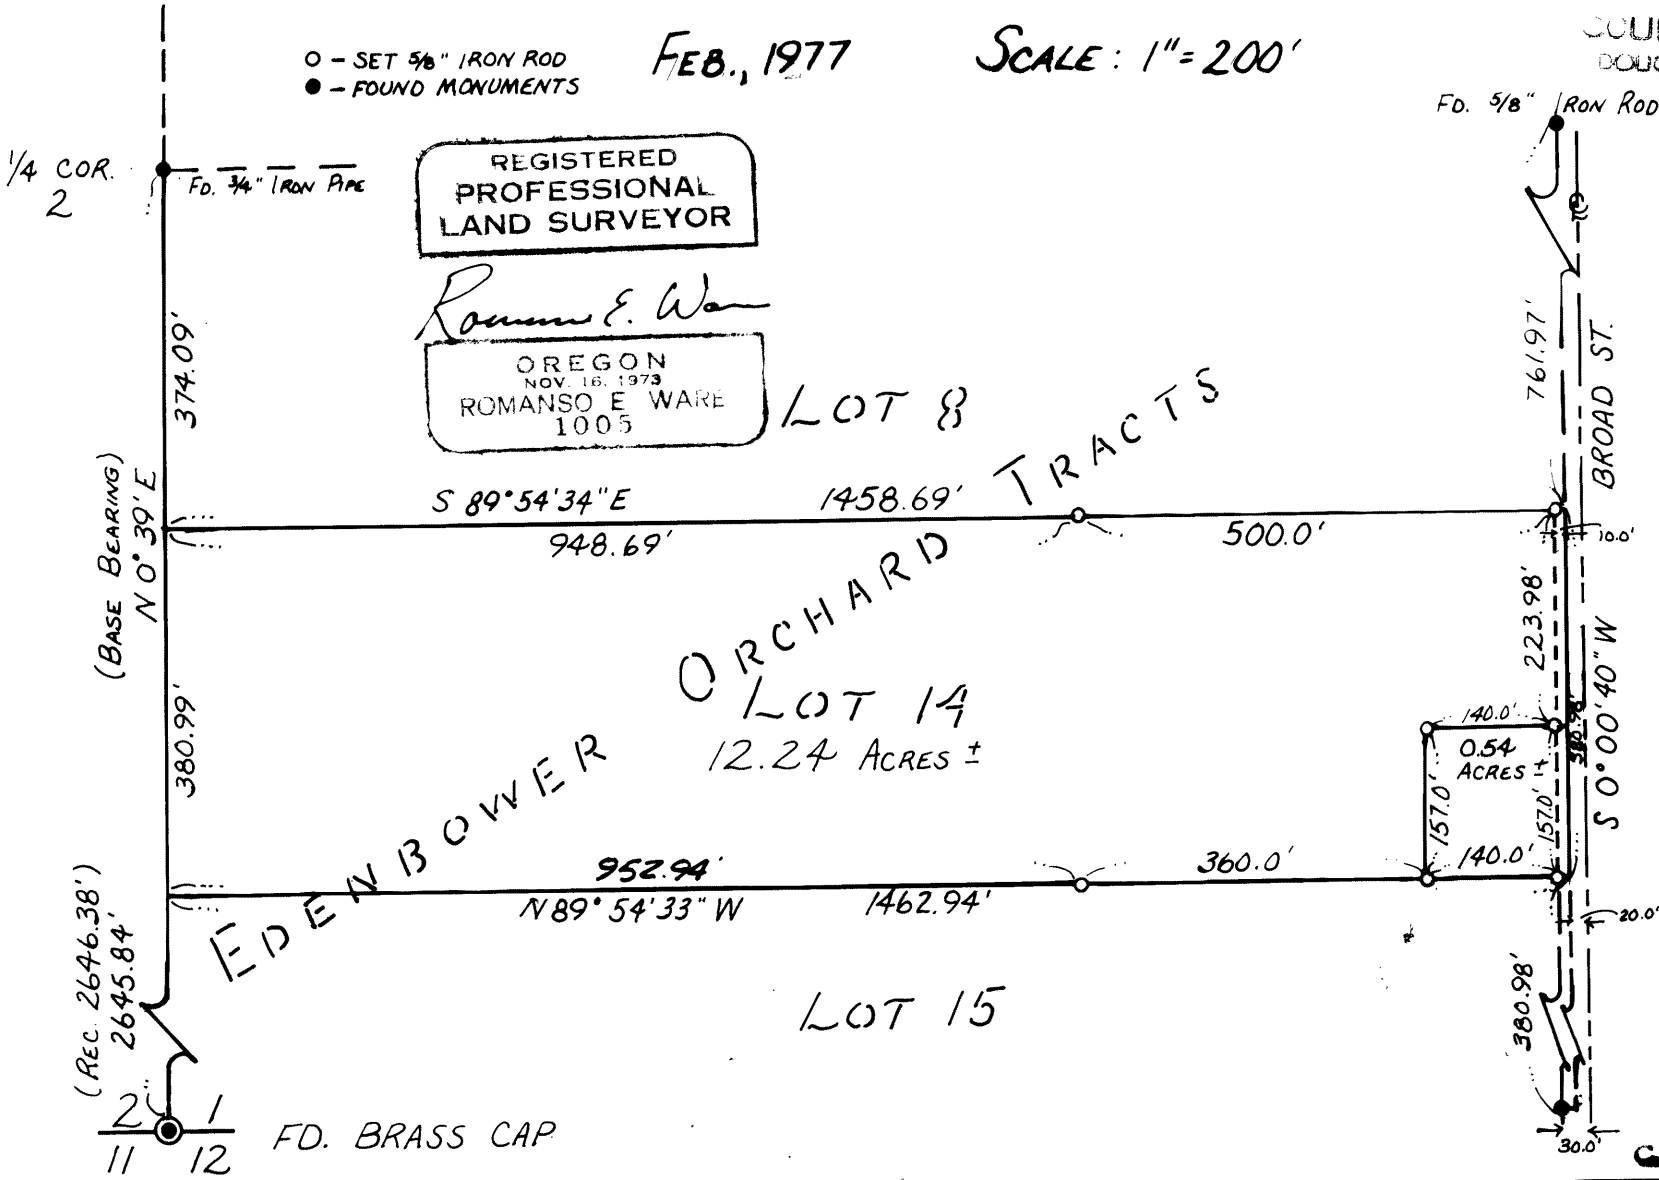

REGISTERED
PROFESSIONAL
LAND SURVEYOR

Romans E. Ware

OREGON
NOV. 16, 1973
ROMANSO E WARE
1005

LOT 8
EDENBOWER ORCHARD TRACTS

LOT 14
12.24 ACRES ±

LOT 15