


PUBLIC LAND CORNERS

FILED
RECEIVED *JK*

WEYERHAEUSER COMPANY DEC 22 1980

SPRINGFIELD BRANCH COUNTY SURVEYOR
DOUGLAS COUNTY, ORE.

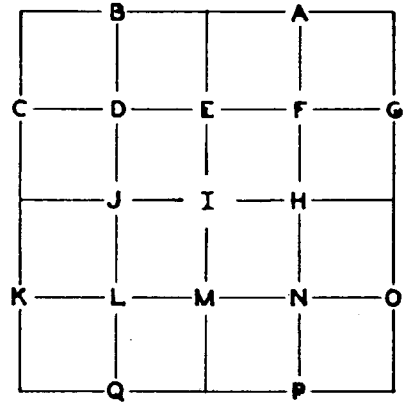

TOWNSHIP 21S RANGE 4W

SECTION 2 CORNER Property

COUNTY Lane - Douglas OREGON

GLO SURVEY RECORD
DATE: _____
CORNER _____

PRESENT CONDITION - (DESCRIBE FULLY -
USE PAGE 2 IF NEEDED FOR EXPLANATION.)

ACCESSORIES:

| | BEARING- | LINKS- | FEET- |
|--|----------|--------|-------|
| | | | |
| | | | |
PRESENT CONDITION: _____

SURVEY RECORD
DATE: _____


PRESENT CONDITION: _____

CORNER SET: 5/8" Monel pipe See page 2 MAG. DECL.: _____

BEARING AND DISTANCE TO ABOVE IDENTIFIED SURVEY ACCESSORIES:

| BEARING- | FEET- | SURVEY - |
|----------|-------|----------|
| | | |
| | | |
SECTION 2 TOWNSHIP 21S RANGE 4W

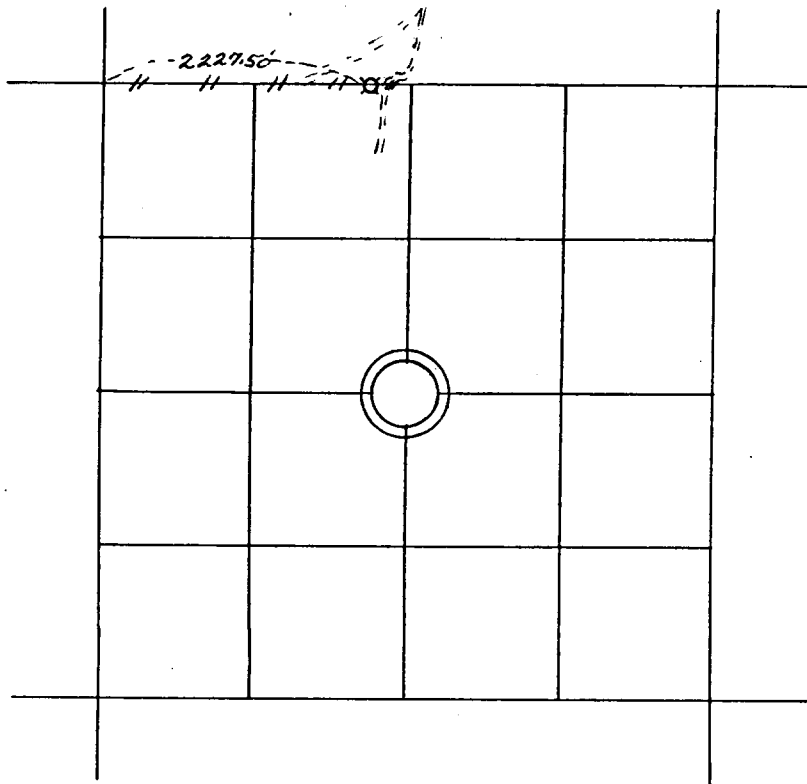

— // — // — // — LINE MARKED BY NOTCH CUT IN BLAZE.

○ ——— KNOWN CORNER.

⊗ ——— REFERENCED CORNER
BY WEYERHAEUSER
METHOD.

This property corner was set from a closed transit traverse survey, linear precision 1 in 7078, the Deed call distance of 135 rods (2227.5') on section line easterly of the northwest section corner.

CS 58/139-7b

ACCESSORIES ADDED THIS DATE:

MAGNETIC DECLINATION 20°E

| | BEARING | FEET | ORIG. B.T. | "W" NAIL | PLATE | BRASS DISC |
|----------------|---------|------|------------|----------|-------|------------|
| 16" Chinquapin | N58E | 11.9 | -- | X | X | -- |
| 6" Madrone | S25W | 8.5 | -- | X | X | -- |
| | | | | | | |
| | | | | | | |

IDENTIFIED ON PHOTO:

INFORMATION ON LOCATION OF CORNER AS NOW SET:

GROUND COVER: Salal, chinquapin, vine maple

(USING FORM LINES SKETCH TOPOG AT CORNER ON PAGE 2 PLAT)

SLOPE FACES (GIVE BEARING IN DEGREES) N50W ON MINUS (-) 50%

NORTH: -40%

SOUTH: +40%

EAST: +45%

WEST: -45%

FROM CORNER -

WORK DONE FOR W. CO. _____

FIELD NOTES IN BOOK: _____

BY: Glen McChesney DATE: 5/4/1979
Project ~~XXXXXXXX~~ ENGINEER - SURVEYOR

ASSISTED BY: L. Wilson - Transitman

FILED *z/r*
RECEIVED

DEC 22 1980

COPIES SENT TO: _____
COUNTY SURVEYOR
DOUGLAS COUNTY, ORE.

UNDER THE SUPERVISION OF:

REGISTERED
PROFESSIONAL
LAND SURVEYOR

Frank O. Williams

OREGON
JULY 22, 1966
FRANK O. WILLIAMS
0875

SEAL *70*
58/139/1 PAGE 3