

SURVEY TO SET PROPERTY CORNERS

IN LOTS 29 & 30 MAR DONNA HOMESITES-SEC. 16 T.25S.R.5W.W.M.

FOR: THOMAS SHOREY

BY: C & G ENGINEERING INC.

JULY 1977 SCALE: 1" = 30'



COUNTY SURVEYORS FILE DATA
DO NOT REMOVE FROM OFFICE

FILED
RECEIVED

AUG 13 1977

COUNTY SURVEYOR
DOUGLAS COUNTY, ORE.

- — Set 1/2" iron rod
- — Found 1/2" iron pipe
- ⊙ — Found 5/8" iron rod
- ⦿ — Found 3/4" iron pipe

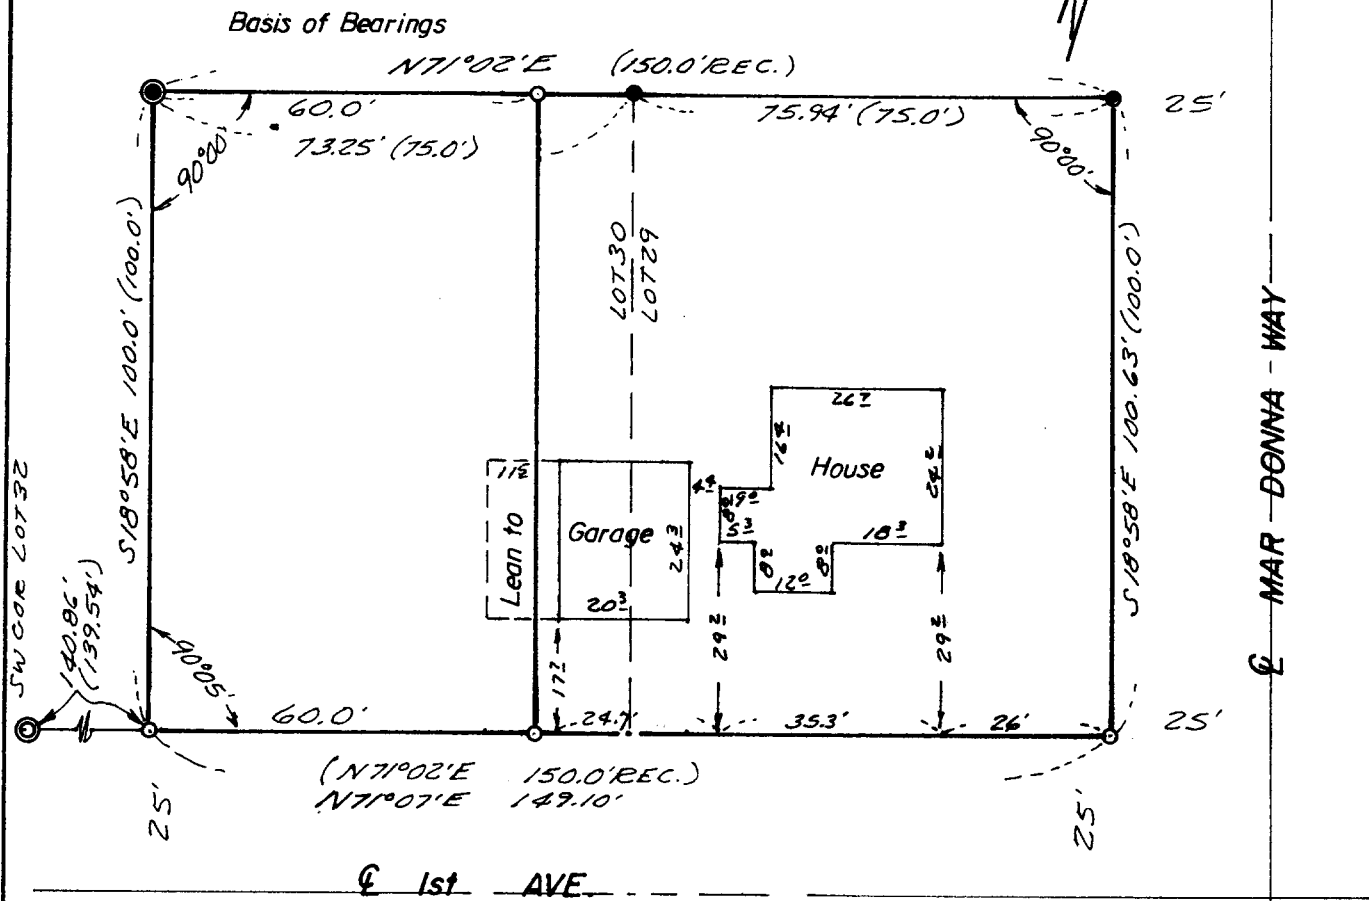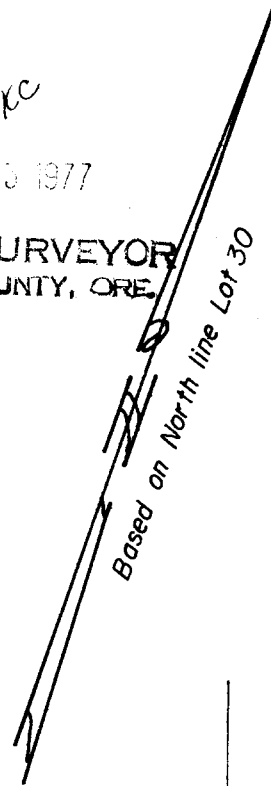

REGISTERED
PROFESSIONAL
LAND SURVEYOR

Glenn S. Baughman

OREGON
JULY 14, 1961
GLENN S. BAUGHMAN
536