

FILED
RECEIVED *AK*

MAR 1 1984

OREGON CORNER RESTORATION FORM

COUNTY SURVEYOR
DOUGLAS COUNTY, ORE

Section 24 Township 26S Range 3W

County Douglas Date 1-31-84

Corner Designation

S.W. Section Corner

- Condition Report Only
- Not Found
- Renewed
- Unrecorded
- Surveyed In
- Referenced Out

Previous Renewals/Surveys, etc. Set at proportionate distance
by B.L.M. in 1972 dependent resurvey.

Monument(s) & Accessories Found: (Condition and Source)

50" fir bears N 31° E, 8.6 Ft. Healed face

17" hemlock bears S 47° E, 14.5 Ft. Healed face

16" hemlock bears S 11° W, 31.1 Ft. (Rec. = 31.7) scribing partially visible

6" hemlock stump, 2' tall, bears N 40° W, 16.0 Ft. (Rec. = 16.5)

Scribed: T26S, R3W, S23 BT


All set & recorded in 1972

Monument Detail

Sketch

Found a 3 1/2" brass cap on a 2 1/2"

I.P. extending 6" above ground

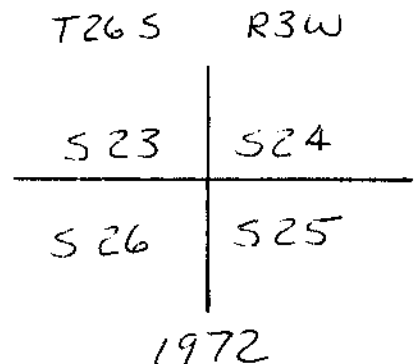

Monument Set (Procedures and Description)

New Accessories

13" Hemlock bears N 13° W, 18.9 Ft.

Scribed: T26S, R3W, S23 BT

Location & Comments

Surveyor's Seal

Compass Declination 20° E

Firm/Agency Champion
Intl. Corp.

Address P.O. Box 1328
Roseburg, Or. 97470

Party Chief L. Sibley

Notes L. Sibley

Witness D. Turner

REGISTERED
PROFESSIONAL
LAND SURVEYOR

Ronald G. Geisler

OREGON
JULY 19, 1932
RONALD G. GEISLER
1969