

FILED  
RECEIVED

AUG 19 1984

OREGON CORNER RESTORATION FORM

Section 32 Township 25S Range 2W

County Douglas Date 8-9-84

COUNTY SURVEYOR  
DOUGLAS COUNTY, ORE.

Corner Designation

1/4 S31/S32

- Condition Report Only
- Not Found
- Renewed
- Unrecorded
- Surveyed In
- Referenced Out

Previous Renewals/Surveys, etc.

Set in 1962 by BLM based on original evidence found

Monument(s) & Accessories Found: (Condition and Source)

Found following BT'S:

14" Fir bears S88 - 1/4<sup>0</sup>E (Rec. = N88 - 1/4<sup>0</sup>E), 57.0' (Rec. = 56.1')

Healed blaze set in 1962

51" Sugar Pine snag (Rec. = White Pine) bears N40<sup>0</sup>W, 6.6'

Healed blaze (original)


23" Fir bears S60<sup>0</sup>E, 24.5' (Rec. = 23.1')

Healed blaze (original)

Monument Detail

Sketch

Found a 3 - 1/2" BLM brass cap, on a  
2 - 1/2" iron pipe

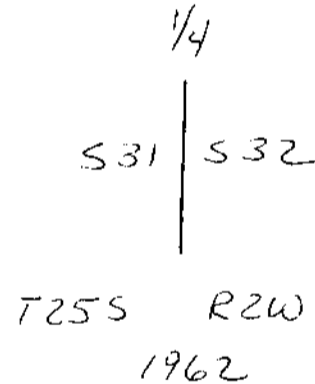

Monument Set (Procedures and Description)

\_\_\_\_\_  
\_\_\_\_\_  
\_\_\_\_\_  
\_\_\_\_\_

New Accessories

\_\_\_\_\_  
\_\_\_\_\_  
\_\_\_\_\_

Location & Comments

\_\_\_\_\_  
\_\_\_\_\_  
Compass Declination 20<sup>0</sup>E

Firm/Agency Champion

International Corp.


Address

Party Chief R. Geisler

Notes L. Sibley

Witness D. Turner

Surveyor's Seal

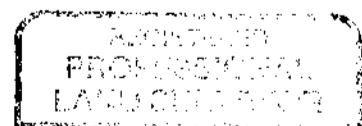

*Ronald J. Geisler*



OK  
JLM  
C.S. File No. 58/146-4