

M 97-68

FILED  
RECEIVED *BS*

OREGON CORNER RESTORATION FORM

DEC 6 1984

Section 25/26 Township 23S Range 10W

COUNTY SURVEYOR  
DOUGLAS COUNTY, ORE.

County DOUGLAS Date 11-7-84

Corner Designation

1/4 S 26/25

- Condition Report Only
- Not Found
- Renewed
- Unrecorded
- Surveyed In
- Referenced Out


Previous Renewals/Surveys, etc. ORIGINAL SURVEY BY BYARS, 1879  
NO OTHER SURVEYS OR RENEWALS OF RECORD

Monument(s) & Accessories Found: (Condition and Source)

FOUND 58" FIR STUMP WITH BARK SCRIBED 'BT' VISIBLE.  
12" MAPLE IS MISSING  
ALSO FOUND 37" CEDAR STUMP (NOT OF RECORD) WITH OLD  
SCRIBING "T225 S26 W" VISIBLE

Monument Detail

Sketch

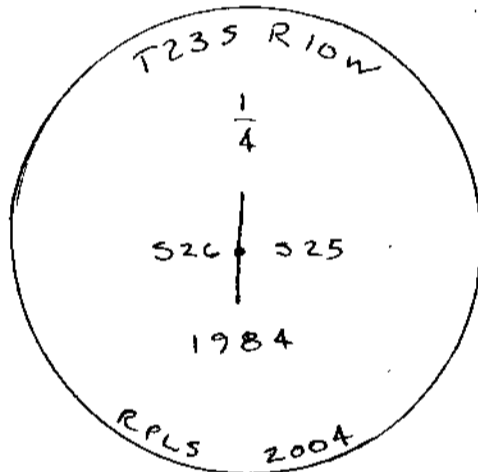

Monument Set (Procedures and Description)

AT RECORD BEARING AND DISTANCE FROM FIR BT, I SET A  
2 1/2" BRASS CAP ATTACHED TO A 2 1/2" GALVANIZED STEEL PIPE  
WITH FLARED BOTTOM, MARKED AS SHOWN ABOVE

New Accessories

- 58" FIR STUMP BEARS WEST, 46<sup>2</sup> FT (1879 BT)
- 37" CEDAR STUMP BEARS N 67° 00' E, 11<sup>2</sup> FT (NO RECORD)
- 16" FIR BEARS N 12° 00' E, 19<sup>2</sup> FT, SCRIBED "1/4 S 25 BT" (1984 BT)
- 18" FIR BEARS N 82° 00' W, 24<sup>2</sup> FT, SCRIBED "1/4 S 26 BT" (1984 BT)

Location & Comments

Surveyor's Seal

DUE TO UPCOMING LOGGING OPERATIONS, I Compass Declination 20° E  
HAVE REMOVED AND HAVE CHAMPION INTERNATIONAL CORP. Firm/Agency  
IN MY POSSESSION THE Address P.O. Box 37  
PIECE OF BARK WITH THE MAPLETON, OR 97453  
SCRIBED "BT" VISIBLE. I Party Chief G. MILLER  
WILL REPLACE IT AFTER Notes R. RICE  
OPERATIONS ARE COMPLETED Witness M. COOK

REGISTERED  
PROFESSIONAL  
LAND SURVEYOR

*Gregory K. Miller*

OREGON  
JULY 16, 1982  
GREGORY K. MILLER  
2004

#1124

C.S. File No. 58/146-7