

M 97-68

FILED  
RECEIVED *BS*

DEC 6 1984

OREGON CORNER RESTORATION FORM

Section 27/26 Township 23S Range 10W  
County DOUGLAS Date 11.7.84

COUNTY SURVEYOR  
DOUGLAS COUNTY, ORE.

Corner Designation

1/4 - S27/S26


Condition Report Only  
 Not Found  
 Renewed  
 Unrecorded  
 Surveyed In  
 Referenced Out

Previous Renewals/Surveys, etc. ORIGINAL SURVEY BY BYARS, 1879  
RESURVEYED BY WALKER, 1906 - DID NOT FIND BYARS CORNER; SET  
THIS CORNER AT POINT OF PROPORTIONATE MEASURE.

Monument(s) & Accessories Found: (Condition and Source)  
FOUND 24" FIR STUMP WITH SCRIBED 'T' VISIBLE (NE BT, 1906)  
ALSO FOUND ROTTED FIR STUMP CLOSE TO POSITION OF NW BT

Monument Detail

Sketch

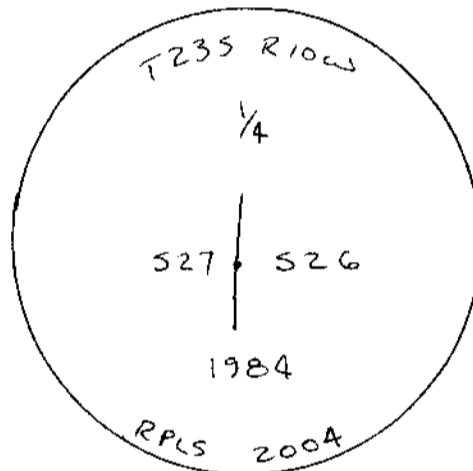

Monument Set (Procedures and Description)

COULD NOT POSITION MONUMENT BY RECORD DISTANCES FROM BT'S. THE  
NE BT IS ON FLAT GROUND RELEVANT TO THE CORNER AND AT A SHORT  
PULL, SO I SET MY MONUMENT AT RECORD BEARING AND DISTANCE FROM  
THE NE BT. SET A 2 1/2" BRASS CAP ON A 2 1/2" x 30" GALVANIZED STEEL  
PIPE WITH FLARED BOTTOM, MARKED AS SHOWN ABOVE

New Accessories

24" FIR STUMP BEARS N65°00'E, 5 1/2 FT (1906 BT)  
25" FIR STUMP BEARS [N65°00'W, 22 1/4 FT (1906 BT)-REC.] Meas: N69°W, 25.9 FT  
6" FIR BEARS N4°00'E, 25 1/2 FT, SCRIBED "1/4 S26 BT" (1984 BT)  
6" FIR BEARS S63°00'W, 21 1/2 FT, SCRIBED "1/4 S27 BT" (1984 BT)

Location & Comments

Surveyor's Seal

Compass Declination 20°E  
Firm/Agency CHAMPION INTERNATIONAL CORP  
Address P.O. Box 37  
MARLETON, OR 97453  
Party Chief G. MILLER  
Notes R. RICE  
Witness M. COOK

REGISTERED  
PROFESSIONAL  
LAND SURVEYOR

*Gregory K. Miller*

OREGON  
JULY 16, 1982  
GREGORY K. MILLER  
2004

#111 \*

C.S. File No. 58/146-8