

M 97-79

FILED  
RECEIVED *BB*

OREGON CORNER RESTORATION FORM

DEC 13 1984

Section 7/18 Township 215 Range 11W

COUNTY SURVEYOR  
DOUGLAS COUNTY, ORE.

County DOUGLAS Date 12-3-84

Corner Designation

$\frac{1}{4}$  S7/S18

- Condition Report Only
- Not Found
- Renewed
- Unrecorded
- Surveyed In
- Referenced Out


Previous Renewals/Surveys, etc. ORIGINAL SURVEY BY MELDREUM, 1867  
No OTHER SURVEYS OR RENEWALS OF RECORD

Monument(s) & Accessories Found: (Condition and Source)

NONE

Monument Detail

Sketch

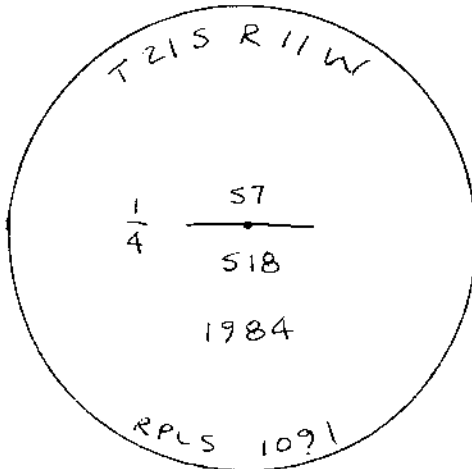

Monument Set (Procedures and Description)

AT POINT OF PROPORTIONATE MEASURE, SET A 2 1/2" BRASS CAP ATTACHED TO A 2 1/2" X 30" GALVANIZED STEEL PIPE WITH FLARED BOTTOM, MARKED AS SHOWN ABOVE.

New Accessories

- 12" ALDER BEARS S 8° 16' E, 38<sup>±</sup> FT BARK SCRIBED 1/4 S18 BT (1984 BT)
- 13" ALDER BEARS N 57° 19' W, 12<sup>±</sup> FT BARK SCRIBED 1/4 S7 BT (1984 BT)

Location & Comments

Surveyor's Seal

Compass Declination 20°E  
 Firm/Agency CHAMPION INTERNATIONAL CORPORATION  
 Address P.O. Box 37  
MAPLETON, OR 97453  
 Party Chief R. WARD  
 Notes R. RICE  
 Witness \_\_\_\_\_

