

M 97-79

FILED
RECEIVED BS

DEC 13 1984

OREGON CORNER RESTORATION FORM

Section 7 Township 21S Range 11W

County DOUGLAS Date 12.3.84

COUNTY SURVEYOR
DOUGLAS COUNTY, ORE.

Corner Designation

7 | 8
18 | 17

- Condition Report Only
- Not Found
- Renewed
- Unrecorded
- Surveyed In
- Referenced Out

Previous Renewals/Surveys, etc. ORIGINAL SURVEY BY MELDRUM, 1857
MELDRUM'S CORNER LOST, RESET BY THIEL, 1891

RENEWALS # 33 & #158 (1965 & 1982)

Monument(s) & Accessories Found: (Condition and Source)

Found 2 1/2" BCIP (RENEWAL #158) NEXT TO 1 1/2" IRON PIPE (RENEWAL #33)

48" FIR BEARS N 42° 00' E, 25.8 FT (1891 BT)

46" FIR BEARS N 25° 00' W, 29.8 FT (1891 BT)


19" ROTTED FIR STUMP BEARS S 72° 00' W, 18.4 FT (1891 BT)

16" FIR BEARS S 41° 00' E, 49.1 FT (1982 BT)

24" FIR BEARS S 82° 00' W, 40.8 FT (1982 BT)

Monument Detail

Sketch

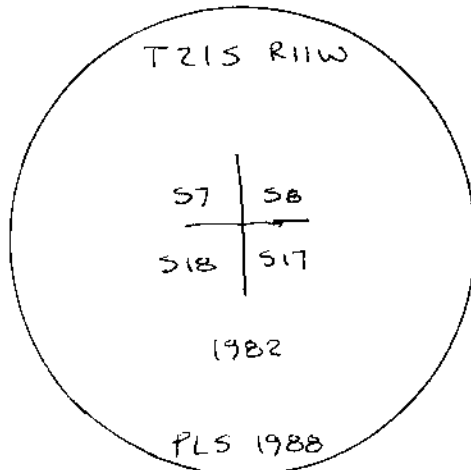

Monument Set (Procedures and Description)

NONE

New Accessories

NONE

Location & Comments

Surveyor's Seal

Compass Declination 20° E

Firm/Agency _____

CHAMPION INTERNATIONAL CORP.

Address P.O. Box 37

MAPLETON, OR 97453

Party Chief R. WARD

Notes R. RICE

Witness _____

