

Prepared for

H. A. JOHNSON

Showing

Lot 4 Ecklund Addition to Canyonville, Oregon.


Scale 1" = 20' May 1956

T. 30-5 Sec. 27 NE SW

FILED ✓
RECEIVED ✓

AUG 29 1977

COUNTY SURVEYOR
DOUGLAS COUNTY, ORE.
North ✓

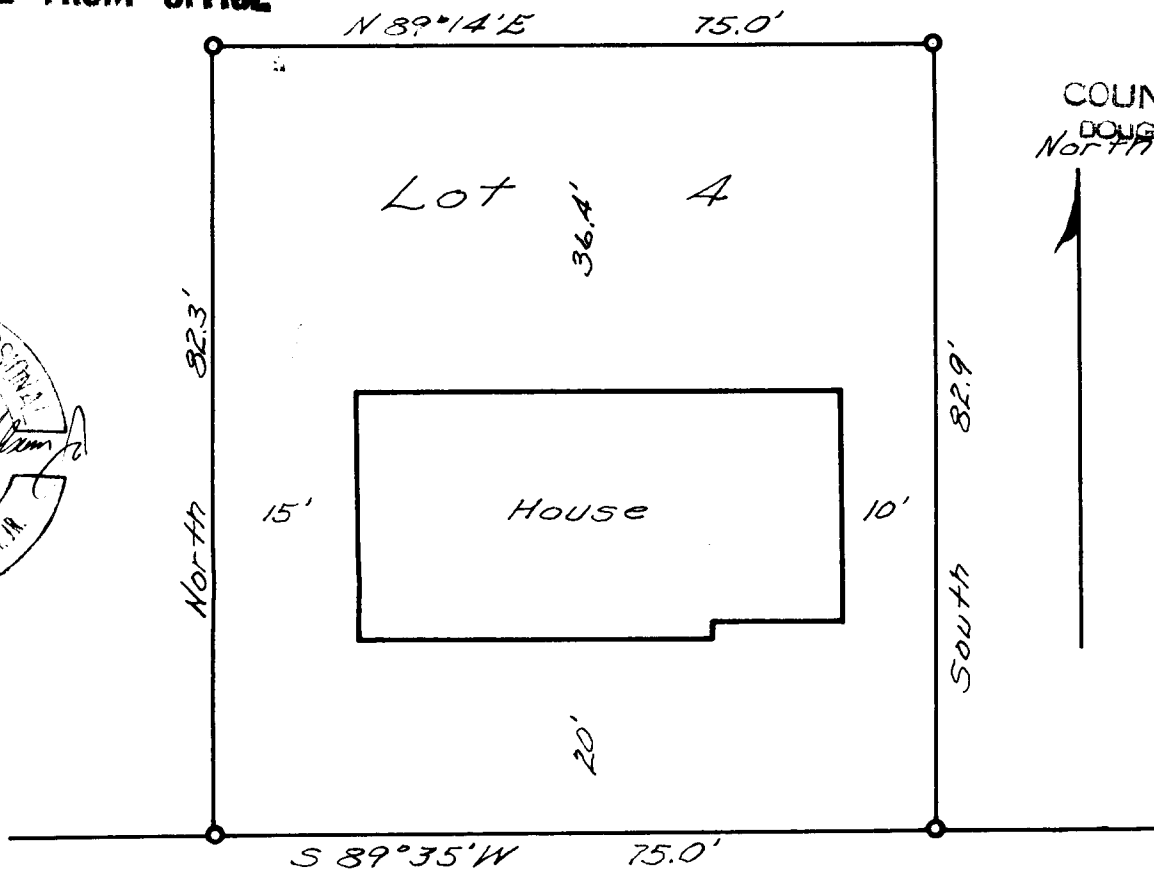

50' ECKLUND STREET

I hereby certify that I have correctly surveyed the above described property and the improvements shown and described hereon are within the property lines

G.S. No. 58/151-4

John H. Washburn, Jr.