

FILED *J*

RECEIVED *VB*

Prepared for

Mr. Allen

AUG 29 1977

COUNTY SURVEYOR

DOUGLAS COUNTY, OREGON


Showing
Lot 7, Block 2, Anderson 2^d Addition, City of Astoria, Oregon
Denotes iron pipes
Scale 1"=20' Aug. 15, 1951

T. 30-5 SW SW. SEC. 27

I hereby certify that I have surveyed
the above described property and that
the improvements shown & described
thereon are within the property lines.

John H. Matheson Jr.

COUNTY SURVEYORS FILE DATA
DO NOT REMOVE FROM OFFICE

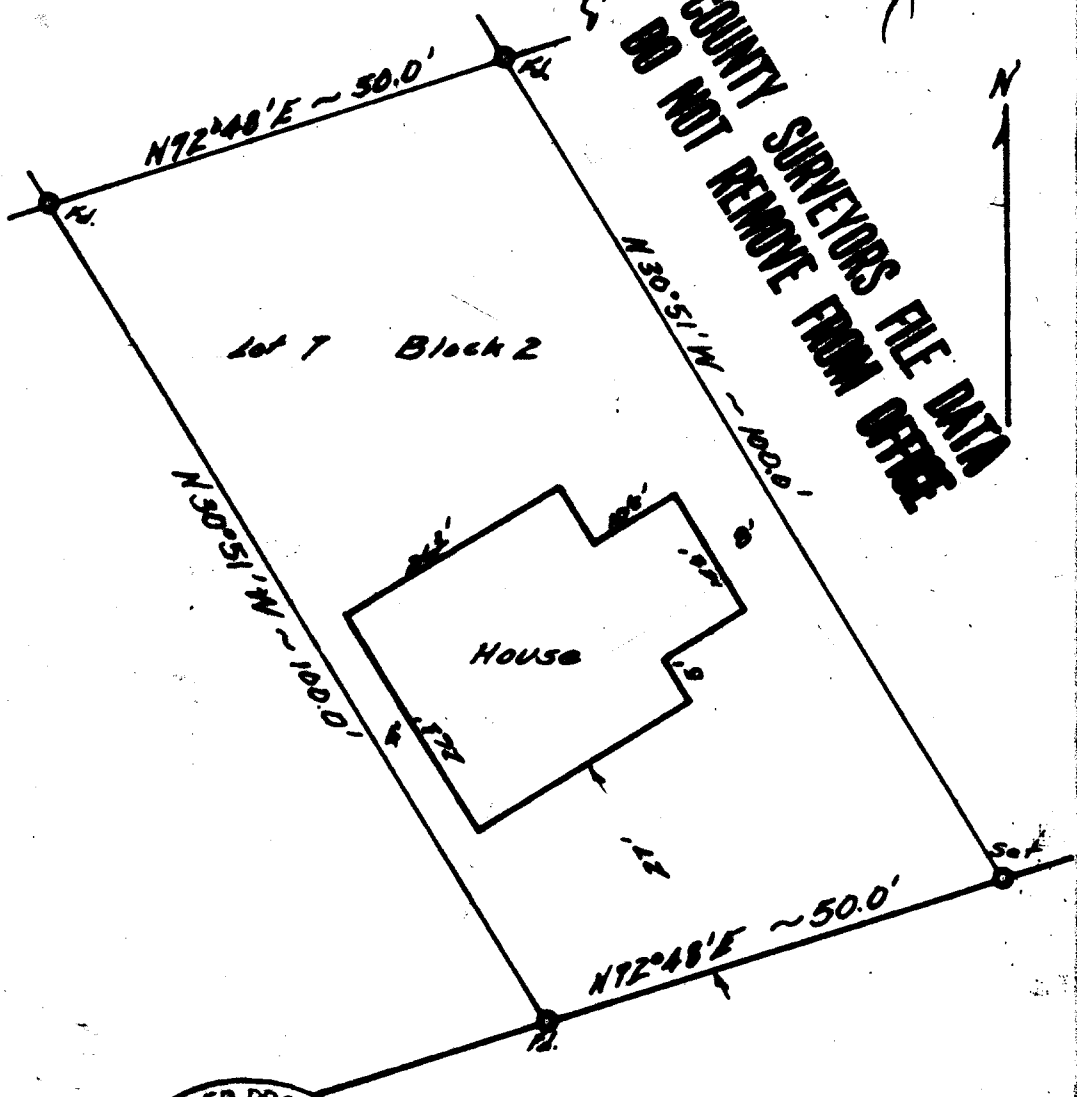

CS 58/151-18

~~CS 58/151-18~~