


CERTIFIED RECORD OF LAND CORNER MONUMENTATION

History of original corner establishment:

Jan. 8, 1857 by Dennis Hathorn  
Set Post with B. T. 's  
A 18" Fir bears S 14° E 12 lks.  
A 12" Fir bears N 50° E 3 lks.  
A 9" Fir bears N 75° W 13 lks.  
A 10" Laurel bears S 68° W 22 lks.

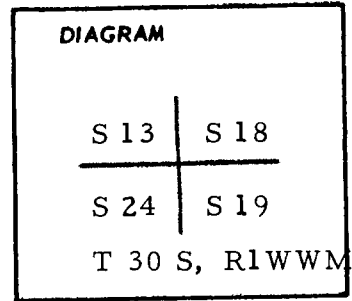

FILED

RECEIVED *dh*

MAY 28 1978

COUNTY SURVEYOR  
DOUGLAS COUNTY, ORE.

Description of corner evidence found:

I found a 1" I. P. w/2½" Brass Cap 14" above ground with B. T. 's  
8" D. Fir stob bears S 9° E 7.9 feet (Rec. S 14° E) scribes vis. open blaze  
20" D. Fir bears S 53½° E 14.8 feet bark scribes vis.  
18" D. Fir stump bears S 79° W 19.4 feet bark scribes vis.  
24" D. Fir bears N 56° E 20.0 feet bark scribes vis.  
24" D. Fir bears N 62° W 48.2 feet bark scribes vis.  
Found 6" x 8" x 5" high stone buried alongside 1" I. P.  
Corner lies at the foot of a very steep north slope and 50 feet south of dirt road  
built recently. Corner has been run over by Cat. during logging and iron pipe  
is badly bent.

Description of monument and accessories I established to perpetuate the  
original location of this corner

New B. T. 10" Madrone bears S 74° W 18.0 feet  
scribed T30S R2W S24 BT on double blazed face.

Office of County Surveyor County of DOUGLAS  
State of OREGON, I hereby certify that the within instrument was filed in this office  
for record on the 23 day of MAY, 1978, at 8 o'clock A.m., (signed)  
Francis Dubois by \_\_\_\_\_  
(COUNTY OFFICIAL) (DEPUTY)

# 181-T30-1

# 209-T30-2