


(SEE FOLDER FOR REMAINING INFO) S. FILE No. 58/154-1

KON:

SAVE THESE NOTES SO CAN RECORD ON MAP.

STEVE PRICE

Steve Price 1167-19

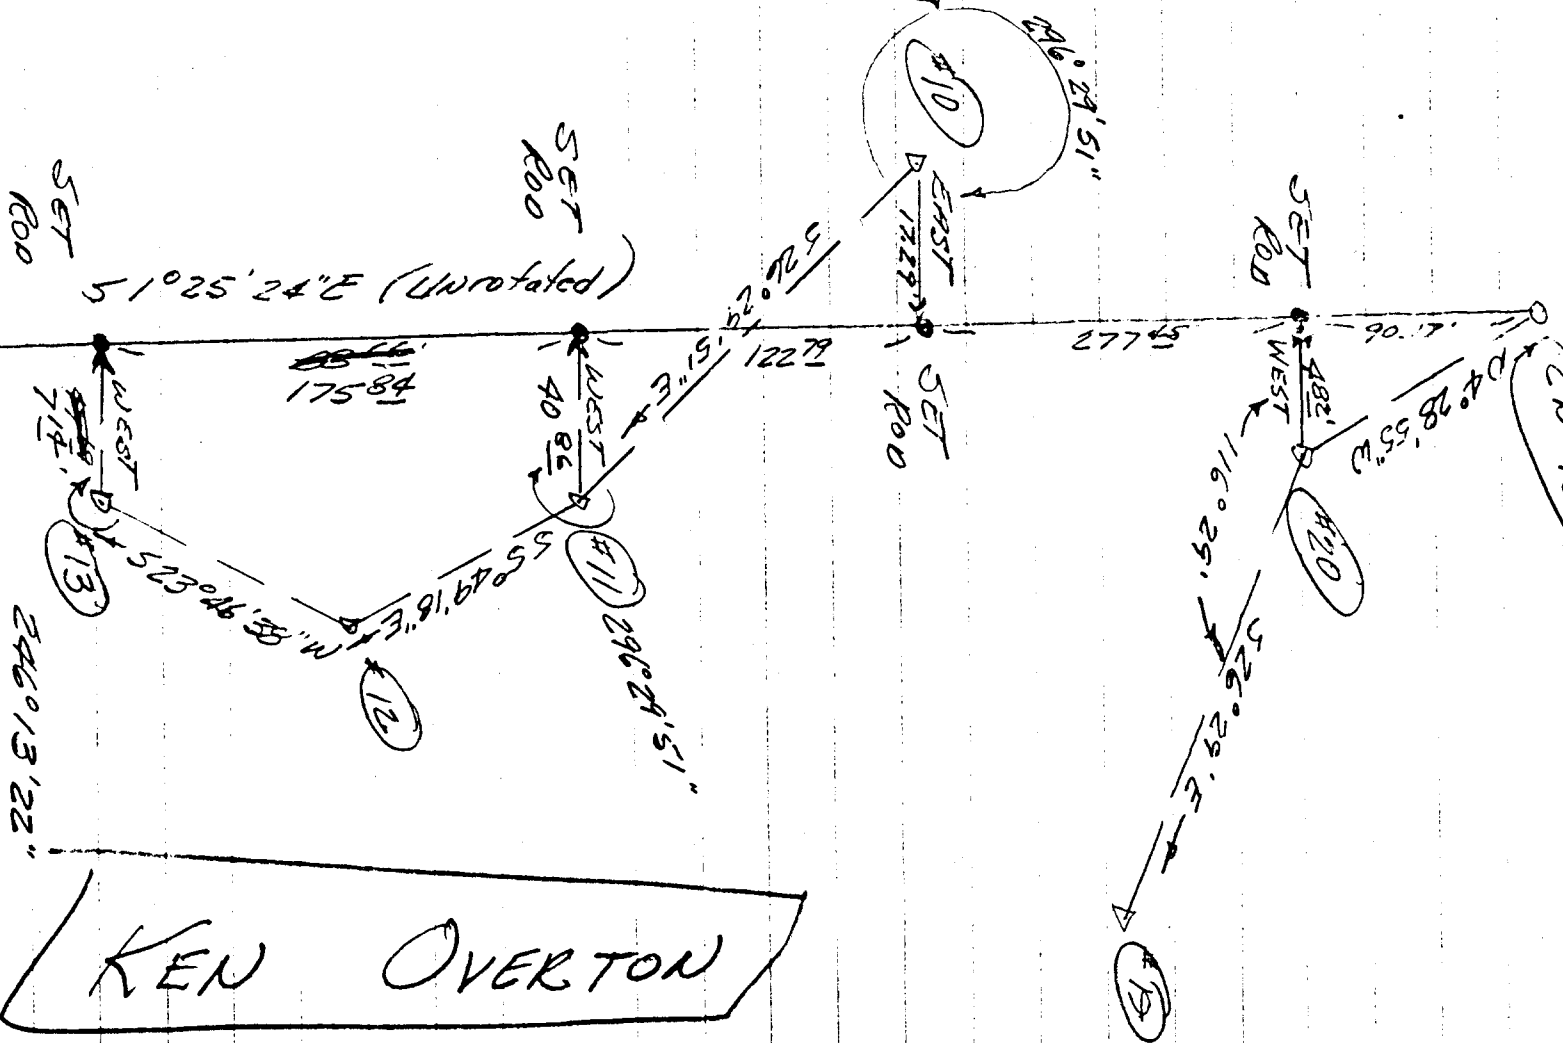

KEN OVERTON