

RESTORED CORNER FOR STATE OF OREGON-- DEPARTMENT OF FORESTRY

Closing Township corner common to Sections 31 and 36, T22S, R11 & 12W, W.M., Coos and Douglas Counties, Oregon.

ORIGINAL

24" x 12" x 6" stone (found lying face down, notches on north face badly eroded) from which a:

- 20" dead Cedar bears N54°E 18 lks.; missing.
- 24" Cedar stub bears N85½°W 118 lks.; missing.
- 36" Fir stub bears S71°E 69 lks.; missing.

RESTORATION by A.G. Gibson, 1958

Built mound of stone around original stone (found mound of stone scattered) from which a:

- 25" Fir bears N17°E 19.4 ft.; now 28" x 4" high stub in place, badly decayed, scribes 22S R11W S31 visible.
- 29" Fir bears N30°W 103.6 ft.; now 32" windfall 5 ft. downhill, face closed.
- 31" Fir bears S20°E 25.8 ft.; now 31" windfall, face closed.

RESTORED MAGNETIC VARIATION 20½°E

Set 1½" x 36" aluminum pipe with 3 3/4" aluminum cap marked "STATE OF OREGON DEPARTMENT OF FORESTRY T22S R11W R12W CC S36 S31 T23S R12W S1 1982 LS1101", 34 inches in ground, placed original 24" x 12" x 6" stone alongside, and from which a:


- 25" Cedar bears N13°W 36.8 ft. to face; scribed T22S R12W S36 CC BT.
- 9" Cherry bears N80°E 59.7 ft. to face; scribed T22S R11W S31 CC BT.

Set 4" x 4" x 72" white painted Cedar post S49°W 2.4 ft. from corner pipe. Oregon State Forestry Department metal location poster on 25" Cedar N13°W 36.8 ft.

Date December 22, 1982

Restored by James M. McIntosh under my direction.
James M. McIntosh, Engineer

Present and witnessed by Anthony J. Koreiva

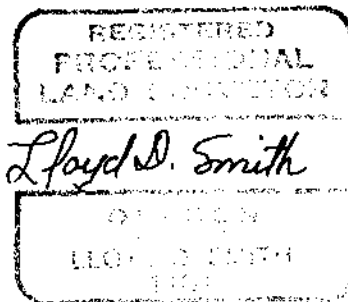

FILED
RECEIVED
DEC 30 1982
COUNTY SURVEYOR
DOUGLAS COUNTY, ORE

T22S
R11W

#155 T22-11

58/164-5