

FILED  
RECEIVED

AUG 27 1984

OREGON CORNER RESTORATION FORM

Section 11 Township 28 S. Range 6W.

County Douglas Date April 18, 1984

COUNTY SURVEYOR  
DOUGLAS COUNTY, ORE.

Corner Designation

N.E. CORNER of D.L.C. # 45


- Condition Report Only
- Not Found
- Renewed
- Unrecorded
- Surveyed In
- Referenced Out

Previous Renewals/Surveys, etc. Corner established 4/26/1916 by ROYER. Survey renewed 4/12/1966 by James W. Byron, County Surveyor.

Monument(s) & Accessories Found: (Condition and Source)

Found 2" iron pipe in fair condition approx 3" below ground surface.

Monument Detail

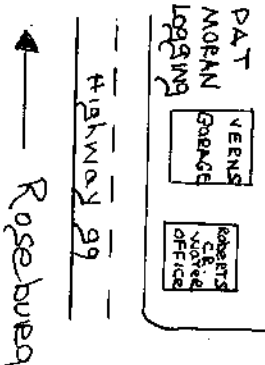

Sketch

WESTERN STAR  
MOBILE HOME PARK

Monument Set (Procedures and Description)

New Accessories

Location & Comments

2" pipe is approx. 3" below gravelled surface and approx 1' east of chain link fence, in vehicle storage area of the mobile home park.

Compass Declination \_\_\_\_\_  
 Firm/Agency O.D.O.T.  
 Address 1038 W Harvard Roseburg, Oregon  
 Party Chief A. Lathrop  
 Notes R small  
 Witness C. Black

Surveyor's Seal

