


FILED *2*
RECEIVED *VR*

MAY 12 1978

COUNTY SURVEYOR
DOUGLAS COUNTY, ORE.

B.S.

2" I.P.
INITIAL PT.

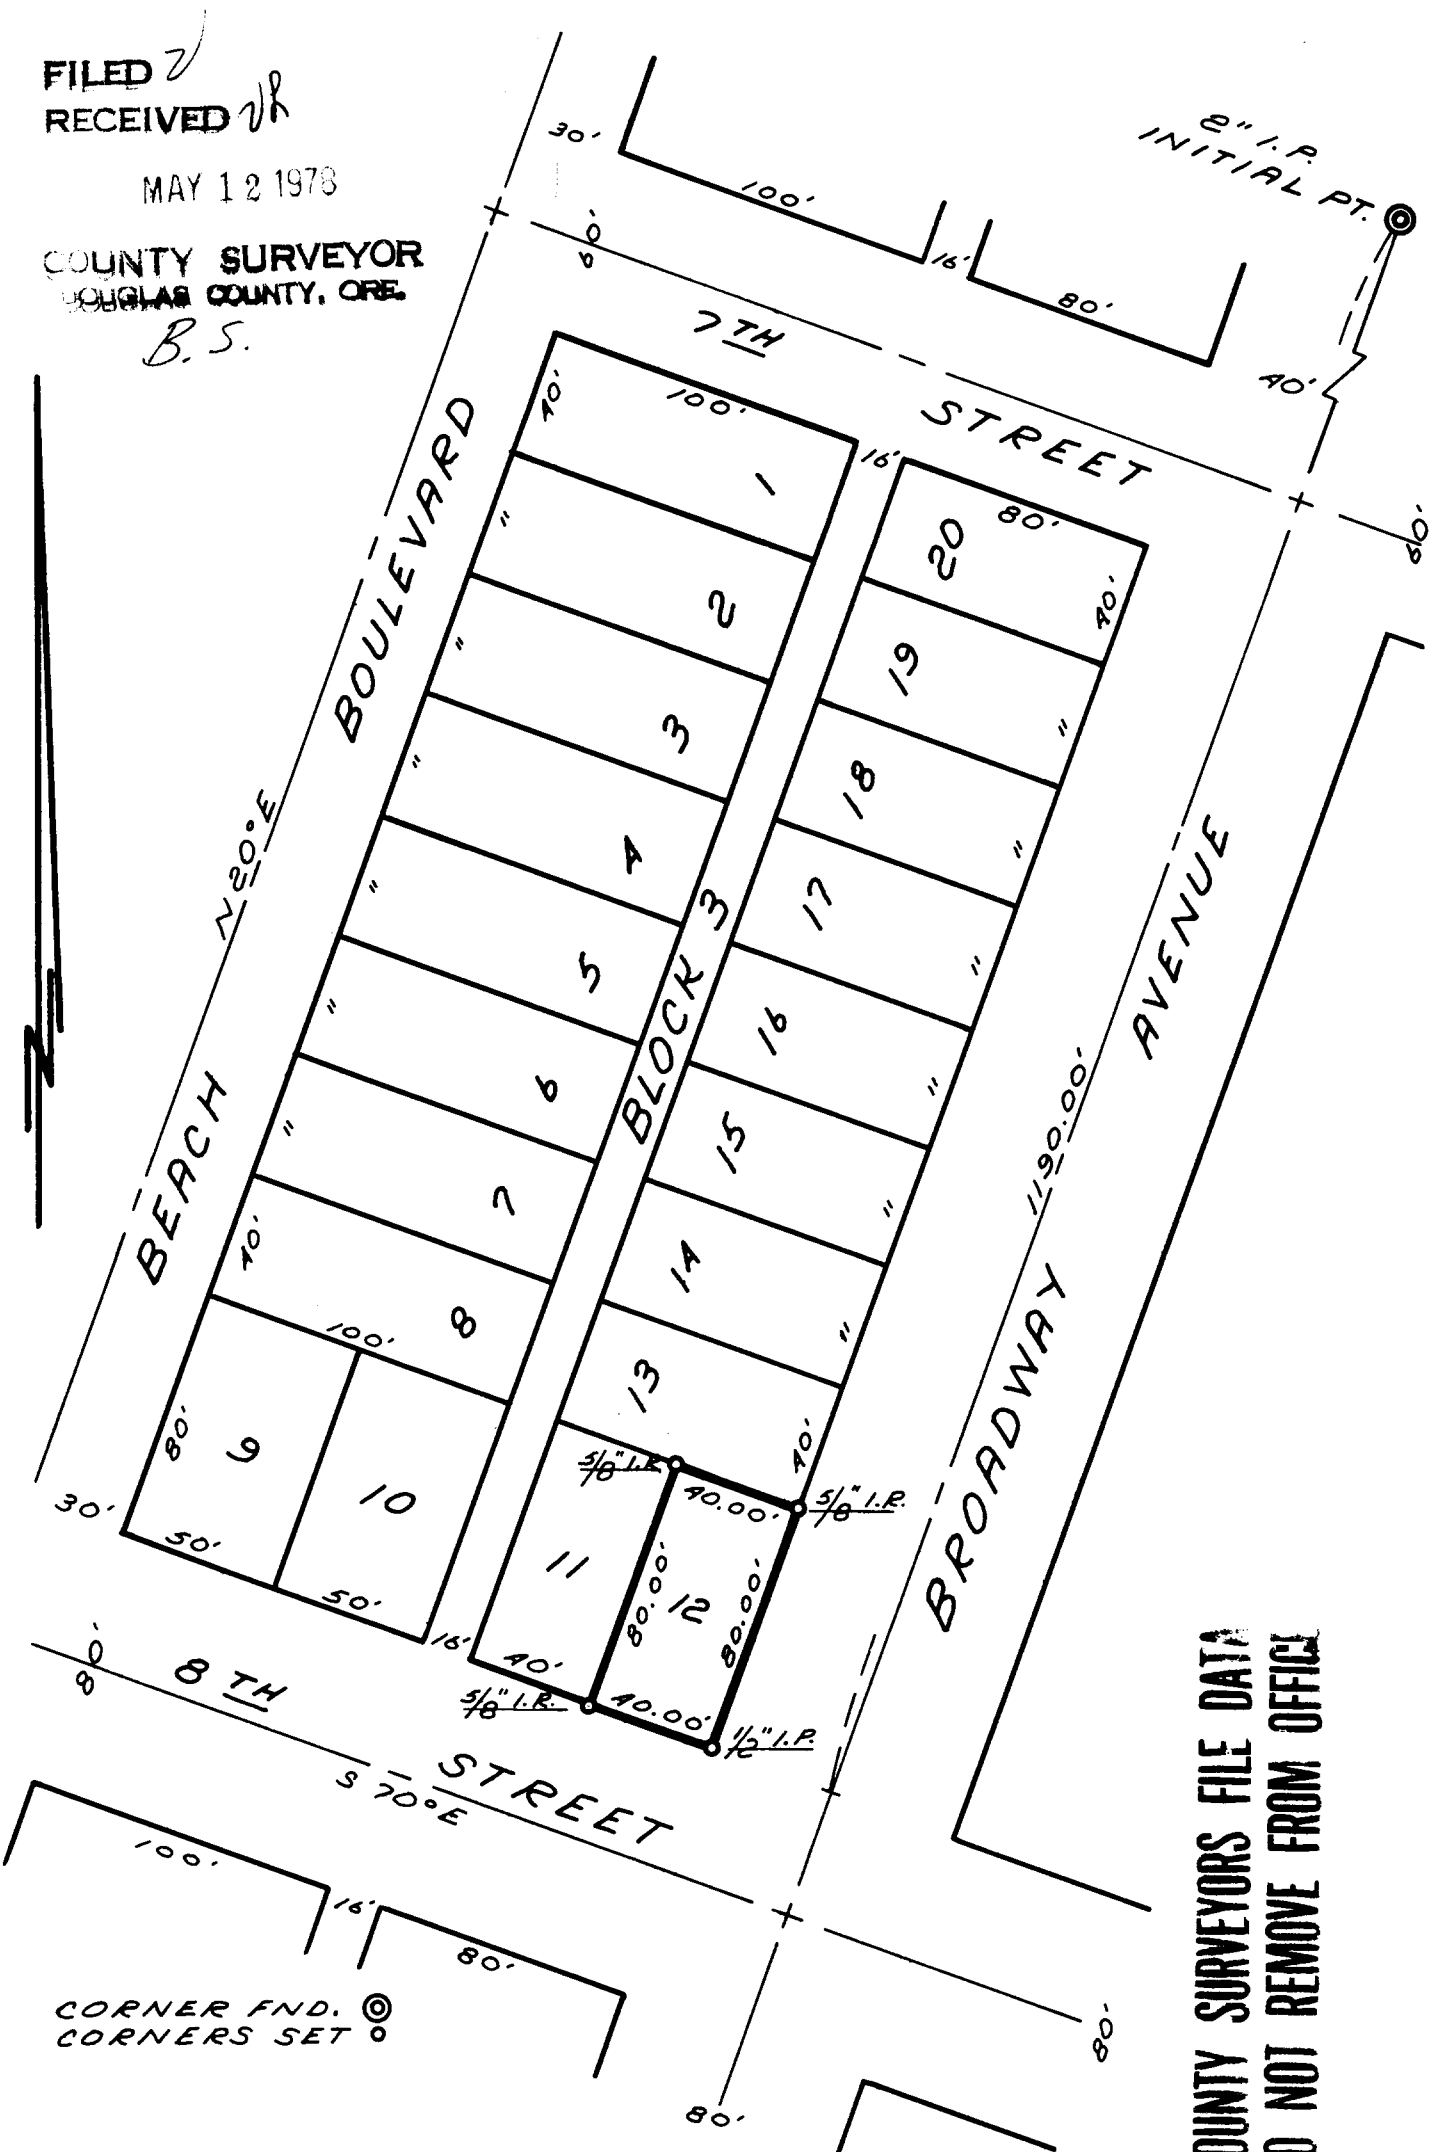

COUNTY SURVEYORS FILE DATA
DO NOT REMOVE FROM OFFICE

REGISTERED
PROFESSIONAL
LAND SURVEYOR
Richard J. Hintz
OREGON
MAY 13, 1960
RICHARD J. HINTZ
497

PROPERTY SURVEY
FOR
LARRY SAUNDERS
LOT 12, BLOCK 3
WINCHESTER BAY
MAY 1978 SCALE 1"=60'
T 22-12 S. 7