
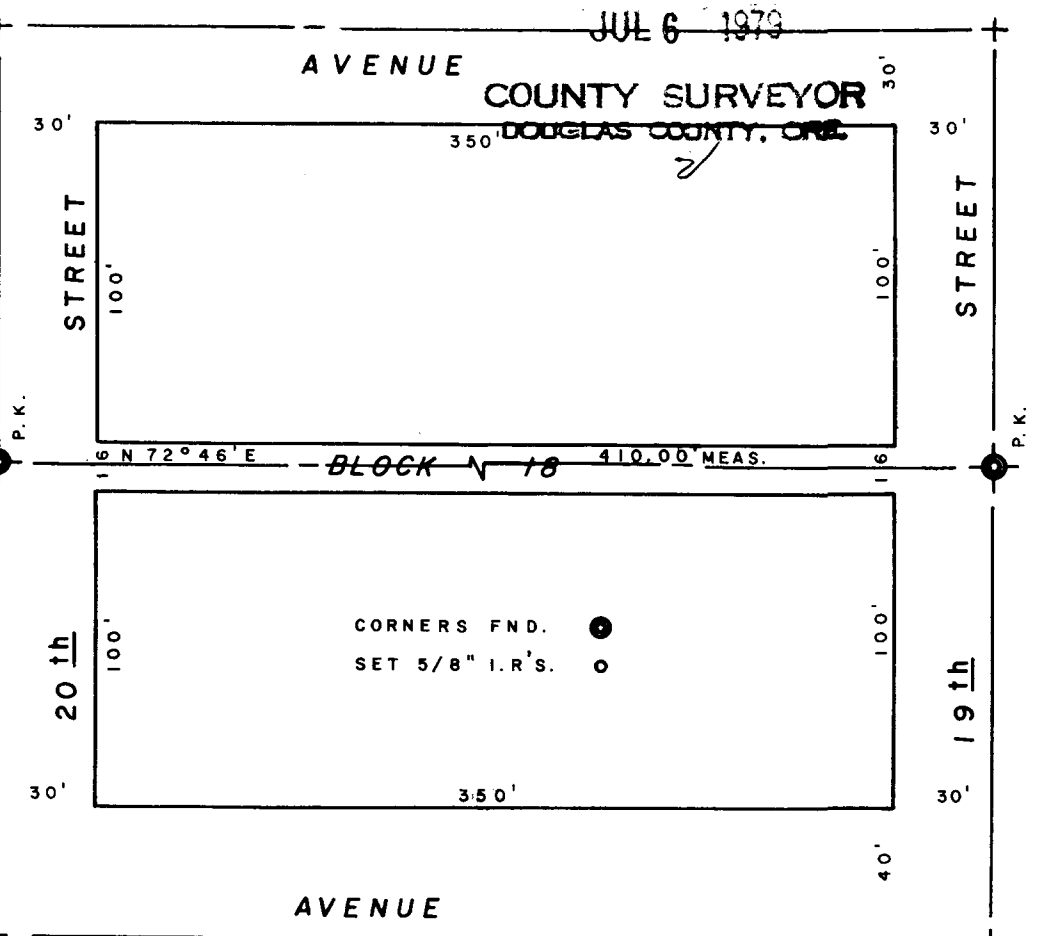


FILED
RECEIVED

JUL 6 1979

COUNTY SURVEYOR
DOUGLAS COUNTY, ORE

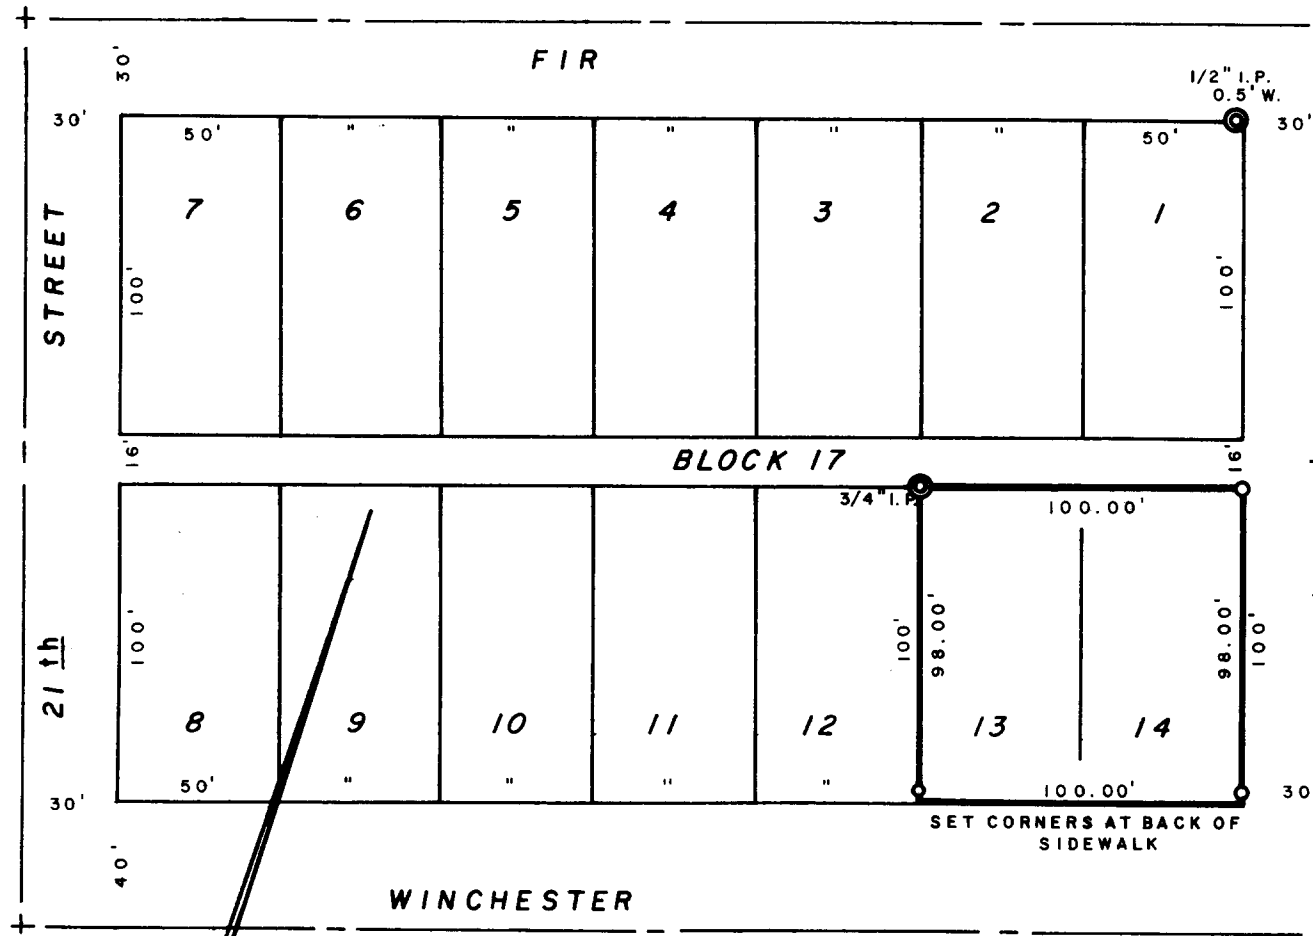

REGISTERED
PROFESSIONAL
LAND SURVEYOR

Richard J. Hintz

OREGON
MAY 12, 1960
RICHARD J. HINTZ
494

COUNTY SURVEYORS FILE DATA
DO NOT REMOVE FROM OFFICE

PROPERTY SURVEY
FOR
THE SOUTHLAND CORPORATION
LOTS 13 & 14, BLOCK 17, CITY OF REEDSPORT
NW 1/4, SEC. 3, T 22 S, R 12 W
SCALE 1" = 60' JUNE 1979