

**CERTIFIED RECORD OF LAND CORNER MONUMENTATION**

**History of original corner establishment:**

Re-established corner in it's original position. Set an iron-stone 15 x 10 x 6 inches, 10 inches in the ground . Marked with 5 notches on North and 1 notch on South edge, from which:


a cedar, 28" diam, bears N 5° E, 9 lks dist. mkd T 31 S R 1 W S 30 BT

a madrone, 10 " diam. bears S 43½° E 57 lks dist. mkd T 31 S R 1 W S 31 BT.

a fir, 20" diam. bears S 8° W 70 lks dist. mkd. T 31 S R 2 W S 36 BT.

a yellow-pine, 16" diam. bears N 22° W 34 lks dist. mkd. T 31 S R 2 W S 25 BT

Fred Mensch, October 28, 1906.

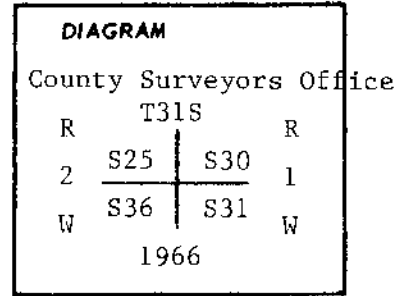

**Description of corner evidence found:**

I found 1" iron pipe with 2½" Brass Cap 14" above ground. With trees:

a cedar, 32" diam. bears N 5°E, 5.7 feet, scribes visible.

a pine snag, 16" diam. bears N 22°W, 22.4 feet, scribes visible.

a pine, 36" diam. bears S 66°E, 87.1 feet, scribes visible.


a laurel, 20" diam. bears S 74½°W, 97.7 feet, scribes visible.

a Douglas-fir, 8" diam. bears S 41°W, 7.5 feet, healed blaze.

a laurel, 10" diam. bears N 66°W, 22.6 feet, scribes visible.

Original Stone set alongside 1" iron pipe. Corner lies on gentle West slope 90 feet West of Brownie Creek Trail.

**Description of monument and accessories I established to perpetuate the original location of this corner**

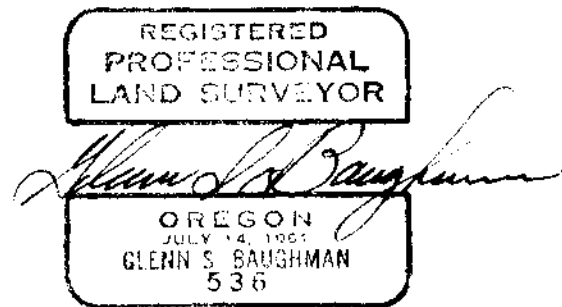

Office of.....Surveyor..... County of.....Douglas.....  
 State of.....Oregon....., I hereby certify that the within instrument was filed in this office  
 for record on the 6 day of July; 19 78 at a o'clock m., (signed)  
 Francis L. Ingram by Gregory C. Tuill (DEPUTY)  
 (COUNTY OFFICIAL)