


CERTIFIED RECORD OF LAND CORNER MONUMENTATION

History of original corner establishment:

Fred Mensch, October 1906. Set an ironstone 12 x 10 x 6 inches 8 inches in the ground for 1/4 sec. corner, mkd 1/4 on W face, from which:

- a fir, 18" diam. bears N 73° E 42 lks dist. mkd 1/4 S 36
- BT.
- a fir, 18" diam. bears S 40° W 42 lks dist. mkd 1/4 S 35
- BT.

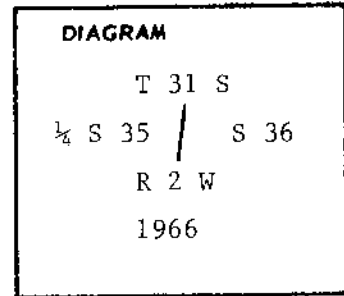

Description of corner evidence found:


Found 1" iron pipe with 2 1/2" Brass Cap, 16" above ground. With Trees:

- a Douglas-fir, 28" diam. bears N 73° E., 26.4 feet, good blazed face. (record 27.7feet)
- a Douglas-fir, 30" diam. bears S 40° W., 27.7 feet, good balzed face.

Corner lies 60 feet South of Tom Creek, course N 70° E.

Description of monument and accessories | established to perpetuate the original location of this corner

REGISTERED  
PROFESSIONAL  
LAND SURVEYOR

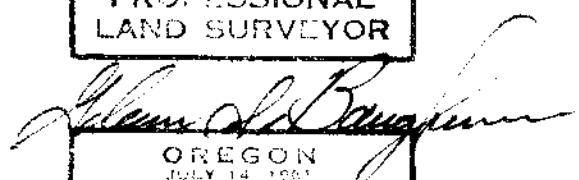

OREGON  
JULY 14 1901  
GLENN S. BAUGHMAN  
536

Office of \_\_\_\_\_ Surveyor \_\_\_\_\_ County of \_\_\_\_\_ Douglas \_\_\_\_\_  
 State of \_\_\_\_\_ Oregon \_\_\_\_\_, I hereby certify that the within instrument was filed in this office  
 for record on the \_\_\_\_\_ 6... day of \_\_\_\_\_ July \_\_\_\_\_, 19 78, at \_\_\_\_\_ 8' clock a \_\_\_\_\_ m., (signed)  
 Francis L. Ingram \_\_\_\_\_ by \_\_\_\_\_ Gregory C. Smith \_\_\_\_\_  
 (COUNTY OFFICIAL) (DEPUTY)