


CERTIFIED RECORD OF LAND CORNER MONUMENTATION

History of original corner establishment:

Re-survey by Fred Mensch, October 28, 1906. Set a basalt stone 15 x 10 x 5 inches, 10 inches in the ground for closing corner of Sections 35 and 36, mkd CC on North with 1 groove in East and 5 grooves in West face, from which:

- a fir, 16" diam. bears N 30° E 30 lks dist. mkd T 31 S R 2 W S 36 BT
- a fir, 30" diam. bears N 45° W 5 lks dist. mkd T 31 S R 2 W S 35 BT

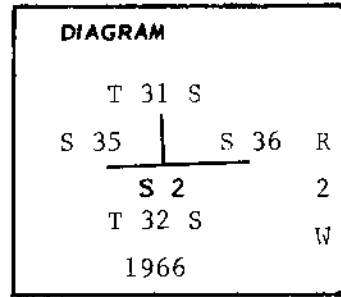

Original: Set an ironstone, 24 x 10 x 4 inches, 18 inches in the ground, for corner of Secs. 5 and 36, marked a notch on the East and 5 notches on the West edges, from which:

- a fir, 24" diam. bears N 67½° E, 42 lks dist. mkd T 31 S R 2 W S 36 BT
- a fir, 24" diam bears N 63° W, 43 lks dist. mkd T 31 S R 2 W S 35 BT

Description of corner evidence found:

Found 1" iron pipe with 2½" Brass Cap, 12" above ground. With Trees:

- a Douglas-fir, 46" diam. bears N 45° W, 4.5 feet, good healed blaze. (record 3.3 feet checks from face)
- a Douglas-fir, 16" diam. bears N 65° E, 19.8 feet, scribe partially visible. (down and burned)
- a Douglas-fir, 32" diam. bears N 27° E, 54.4 feet, good healed blaze. (record 55.0 feet)

Found original corner stone alongside 1" iron pipe.

Corner lies on the Northeast slope, 50 feet South of draw sloping Southeast.

Description of monument and accessories established to perpetuate the original location of this corner

**REGISTERED
PROFESSIONAL
LAND SURVEYOR**

Glenn S. Baughman

OREGON
JULY 14, 1921
GLENN S. BAUGHMAN
536

Office of Surveyor County of Douglas
 State of Oregon, I hereby certify that the within instrument was filed in this office
 for record on the 6 day of July, 19 78, at 8 o'clock a m., (signed)
Francis L. Ingram by Gregory C. Fairchild
 (COUNTY OFFICIAL) (DEPUTY)