


CERTIFIED RECORD OF LAND CORNER MONUMENTATION

History of original corner establishment:

Set a basalt stone 15 x 8 x 6 inches, 10 inches in the ground for 1/4 Section corner, marked 1/4 on North face, from which:
 a fir, 14" diam., bears N 55° E 54 lks distance marked 1/4 S 36 BT.
 a fir, 14" diam., bears N 75° W 25 lks distance marked 1/4 S 36 BT.

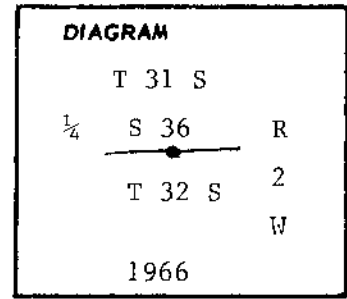

July 1908 By Fred Mensch.

Description of corner evidence found:

Found 1" iron pipe with 2 1/2" Brass Cap, 15" above ground. With Trees:

- a Douglas-fir stump, 16" diam. bears N 50° E, 35.6 feet, scribes visible. (badly rotted)
- a Douglas-fir, 28" diam. bears N 75° W, 16.5 feet, good healed blaze.
- a Douglas-fir, 7" diam. bears N 32° E, 14.9 feet, good healed blaze. (record N 27 1/2° E)

Corner lies on slight West slope, 200 feet East of large swamp.

Description of monument and accessories established to perpetuate the original location of this corner

REGISTERED
PROFESSIONAL
LAND SURVEYOR

Glenn S. Baughman

OREGON
July 14, 1968
GLENN S. BAUGHMAN
536

Office of Surveyor County of Douglas
 State of Oregon, I hereby certify that the within instrument was filed in this office
 for record on the 6 day of July, 1978, at 8 o'clock a.m. (signed)
Francis L. Ingram by Gregory E. Smith
 (COUNTY OFFICIAL) (DEPUTY)