

**CERTIFIED RECORD OF LAND CORNER MONUMENTATION**

**History of original corner establishment:**

Re-establishment by Fred Mensch, in May 1906, contract date.  
 Began survey in October 1906. Land Office Contract No. 766.

Surveyor General records state: Re-established the corner in it's original position as follows:

Set an ironstone 14 x 10 x 4 inches 9½ inches in the ground for ¼ Sec. corner marked ¼ on W face, from which :

- A Cedar 18" bears N 10° E 15 links distance marked ¼ S 31 B T
- A Cedar 28" bears S 47° W 22 links distance marked ¼ S 31 B T

The course of this line is North and the distance 40.25 chains commencing at the ¼ Sec. cor.

**Description of corner evidence found:**


1" iron pipe with 2½" Brass Cap 8" above ground. With Trees:

- 18" Cedar (down and rotted) bears N 10° E, 9.9 feet.
- 28" Cedar Stump (burned and well rotted) bears S 47° W, 14.5 feet.
- 9" Douglas Fir Bears N 15° E, 17.9 feet, healed blaze.
- 12" Douglas Fir bears S 60° W, 17.0 feet, healed blaze.

Corner lies on East slope 50 feet North of Brownie Creek Trail.

Original Stone set alongside 1" iron pipe.

**Description of monument and accessories I established to perpetuate the original location of this corner**

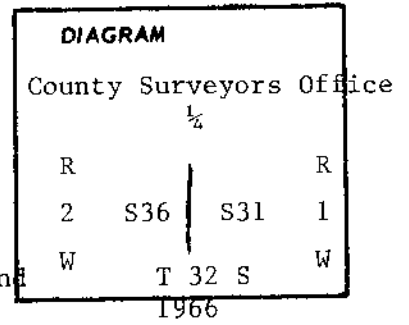

REGISTERED  
 PROFESSIONAL  
 LAND SURVEYOR

*Glenn S. Baughman*  
 OREGON  
 JULY 14, 1961  
 GLENN S. BAUGHMAN  
 536

Office of Surveyor County of Douglas  
Oregon  
 State of Oregon, I hereby certify that the within instrument was filed in this office  
 for record on the 6 day of July, 1978, at 8 o'clock a.m., (signed)  
Francis L. Ingram by Gregory L. Smith  
 (COUNTY OFFICIAL) (DEPUTY)