


CERTIFIED RECORD OF LAND CORNER MONUMENTATION

History of original corner establishment:

Set post corner T 31 and 32 S, R 1 and 2 W, from which:

- a fir, 18" diam. bears S 80 E 14 lks.
- a fir, 10" diam. bears S 67 W 24 lks.
- a fir, 10" diam. bears N 74 W 22 lks.
- a laurel, 10" diam. bears N 50 E 11 lks.

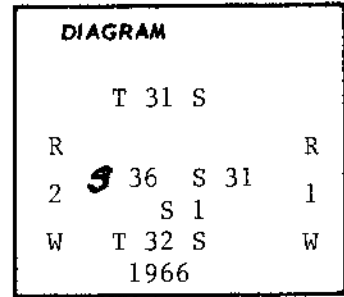

Description of corner evidence found:


Found 1" iron pipe with 2½" Brass Cap, 16" above ground. With Trees:

- a Douglas-fir, 32" diam. bears N 30° E, 38.3 feet, good healed blaze.
- a Douglas-fir, 18" diam. bears N 33° W, 19.1 feet, scribes visible. (Now Down)
- a Douglas-fir, 26" diam. bears N 19° W, 34.6 feet, healed blaze.

Corner lies on Southeast slope on E-W timberline.

Description of monument and accessories I established to perpetuate the original location of this corner

REGISTERED
PROFESSIONAL
LAND SURVEYOR

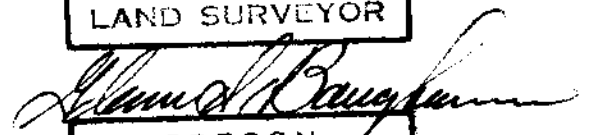

OREGON
JULY 14, 1961
GLENN S. BAUCHMAN
536

Office of Surveyor County of Douglas
 State of Oregon, I hereby certify that the within instrument was filed in this office
 for record on the 6 day of July, 1978, at 8 o'clock a m. (signed)
Francis L. Ingram by Gregory C. Russell
 (COUNTY OFFICIAL) (DEPUTY)