


CERTIFIED RECORD OF LAND CORNER MONUMENTATION

History of original corner establishment:

CORNER ESTABLISHED IN 1908 BY FRED MENSCH, UNDER GENERAL LAND OFFICE CONTRACT NO. 766.

1908 SURVEY NOTES STATE:

SET A GRANITE STONE 18X14X4 INCHES 12 INCHES IN THE GROUND FOR ONE-QUARTER (1/4) SECTION CORNER MARKED 1/4 ON WEST FACE FROM WHICH:

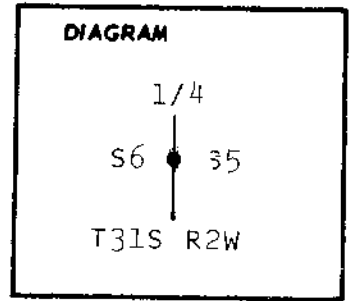

A HEMLOCK, 12 INCHES IN DIAMETER, BEARS S.65°E., 24 LKS. DIST., MARKED 1/4 S5 BT.

A FIR, 12 INCHES IN DIAMETER, BEARS S.51°W., 28 LKS. DIST., MARKED 1/4 S6 BT.

Description of corner evidence found:

FOUND A GRANITE STONE 18X14X4 INCHES MARKING THE ONE-QUARTER (1/4) CORNER, FROM WHICH:

A 20" FIR BEARS S.51°W. 18.5', SHOWS SCARS.

A 20" HEMLOCK BEARS S.65°E. 15.8', SCRIBE VISIBLE.


FILED
RECEIVED *JR*

SEP 7 1978

COUNTY SURVEYOR
DOUGLAS COUNTY, ORE.

Description of monument and accessories I established to perpetuate the original location of this corner

SET A 2" PIPE WITH 3" BRASS CAP STAMPED:

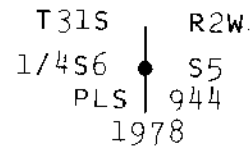

NEW BEARING TREE:

A 16" HEMLOCK BEARS S.10°E. 34.1', SCRIBED 1/4 S5 BT.

NOTE: THE ORIGINAL STONE IS BURIED ALONG SIDE THE 2" PIPE. THE NEW BEARING TREE HAS A BRASS TAG #944 NAILED AT BT SCRIBE.

REGISTERED
PROFESSIONAL
LAND SURVEYOR

I HEREBY CERTIFY THE ABOVE MONUMENT WAS RE-ESTABLISHED IN AUGUST, 1978.

Lloyd R. Moffitt
OREGON
JULY 17, 1970
LOYD R. MOFFITT
944

Office of *County Surveyor* County of *Douglas*
State of *Ore.*, I hereby certify that the within instrument was filed in this office
for record on the *7* day of *September*, 1978, at *10* o'clock *A.*m., (signed)
Francis J. Ingram by *Virginia A. Ferguson*
(COUNTY OFFICIAL) (DEPUTY)

#194 X