


CERTIFIED RECORD OF LAND CORNER MONUMENTATION

History of original corner establishment:

CORNER ESTABLISHED IN 1908 BY FRED MENSCH, UNDER GENERAL LAND OFFICE CONTRACT NO. 766.

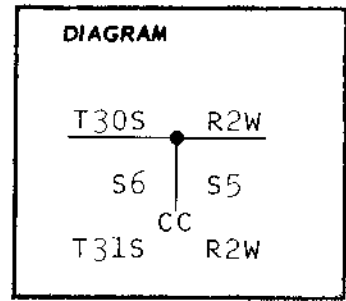

1908 SURVEY NOTES STATE:

SET A GRANITE STONE 15X15X6 INCHES, 10 INCHES IN THE GROUND FOR CLOSING CORNER OF SECTIONS 5 AND 6 MARKED CC ON SOUTH WITH 5 GROOVES ON EAST AND 1 GROOVE ON WEST FACE FROM WHICH:

A MADRONE, 16" IN DIAMETER, BEARS S.14°E., 75LKS. DIST., MARKED T31S R2W S5 BT.

A FIR, 16" IN DIAMETER, BEARS S.14°W., 20LKS. DIST. MARKED T31S R2W S6 BT.

Description of corner evidence found:

FOUND A GRANITE STONE 15X15X6 INCHES MARKING THE CLOSING CORNER OF SECTIONS 5 AND 6, FROM WHICH:

A 36" FIR BEARS S.14°W. 13.2', SCAR HEALED OVER.

A 24" MADRONE (NOW DEAD) BEARS S.14°E. 49.5', SCAR VISIBLE.

FILED
RECEIVED *dh*

SEP 7 1978

COUNTY SURVEYOR
DOUGLAS COUNTY, ORE.

Description of monument and accessories I established to perpetuate the original location of this corner

SET A 2" PIPE WITH 3" BRASS CAP STAMPED:

T30S R2W
 S32
 S6 | S5
 T31S CC R2W
 PLS 944
 1978

NEW BEARING TREE:

A 8" FIR BEARS S.53°E. 21.8', SCRIBED T31S R2W S5 BT

NOTE: THE ORIGINAL STONE IS BURIED ALONG SIDE THE 2" PIPE. THE NEW BEARING TREE HAS A BRASS TAG #944 NAILED AT BT SCRIBE.

REGISTERED
PROFESSIONAL
LAND SURVEYOR

I HEREBY CERTIFY THE ABOVE MONUMENT WAS RE-ESTABLISHED IN AUGUST, 1978.

Lloyd B. Moffitt

OREGON
JULY 27, 1970
LOYD B. MOFFITT

Office of *County Surveyor* County of *Douglas*

State of *Oregon*, I hereby certify that the within instrument was filed in this office for record on the *7th* day of *September* 1978

Francis A. Bergstrom by *Margaret A. Senger*
(COUNTY OFFICIAL) (DEPUTY)

#195 T31-2 X
#215 T30-2 X

© C