


CERTIFIED RECORD OF LAND CORNER MONUMENTATION

History of original corner establishment:

CORNER ESTABLISHED IN 1908 BY FRED MENSCH, UNDER GENERAL LAND OFFICE CONTRACT NO. 766.

1908 SURVEY NOTES STATE:

SET A QUARTZ STONE 18X10X9 INCHES, 12 INCHES IN THE GROUND FOR CORNER OF SECTIONS 31 AND 32, T.30S., R.2W., MARKED WITH 5 NOTCHES ON EAST AND 1 NOTCH ON WEST EDGE, FROM WHICH:

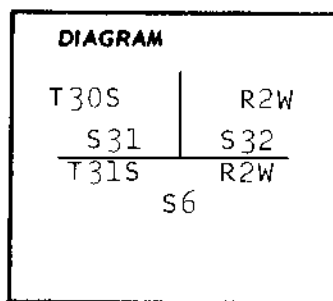

A FIR, 40 INCHES IN DIAMETER, BEARS N.23°E., 189 LKS. DIST., MARKED T30S R2W S32 BT.

A MADRONE, 10 INCHES IN DIAMETER, BEARS N.47 1/2° W., 53 LKS. DIST., MARKED: T30S R2W S31 BT.

Description of corner evidence found:

FOUND A STONE 18X10X9 INCHES MARKING THE SOUTH SECTION CORNER BETWEEN SECTIONS 31 AND 32, FROM WHICH:

A 36 INCH FIR BEARS N.23°E. 124.7', SCAR VISIBLE.


FILED
RECEIVED *SR*

SEP 2 1978

COUNTY SURVEYOR
DOUGLAS COUNTY, ORE.

Description of monument and accessories established to perpetuate the original location of this corner

SET A 2" PIPE WITH A 3" BRASS CAP STAMPED:

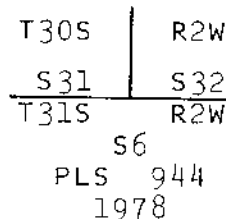

NEW BEARING TREE:

A 8" FIR BEARS N.20°W. 15.4', SCRIBED T30S R2W S31 BT.

NOTE: THE ORIGINAL STONE IS BURIED ALONG SIDE THE 2" PIPE. THE NEW BEARING TREE HAS A BRASS TAG #944 NAILED AT BT SCRIBE.



I HEREBY CERTIFY THE ABOVE MONUMENT WAS RE-ESTABLISHED IN AUGUST, 1978.

Office of *County Surveyor* County of *Douglas*
State of *Oregon*, I hereby certify that the within instrument was filed in this office
for record on the *7th* day of *September*, 1978
Laurie P. Ingram by *Virginia A. Haugen*
(COUNTY OFFICIAL) (DEPUTY)

#196 T31-2 ✓
#214 T30-2 ✓