

CERTIFIED RECORD OF LAND CORNER MONUMENTATION

This corner was originally established by Rufus Moore in 1883 and subsequently re-established by Hans Thielsen in 1955, and by Marvin Ramsey, a professional land surveyor, in 1958.

T.325, R1W, W.M.	
S 15	S 14
S 22	S 23


The recorded monument set by Thielsen was destroyed by logging activity and replaced with a 2 inch O.D. pipe by Ramsey, which I find firmly set in a mound of stone. I find the following bearing trees marked by Thielsen:

- A Douglas Fir 30 inch diam. w/healed blaze bears S. 62 $\frac{1}{2}$ ^oW. 92.5 ft. (record S. 62 $\frac{1}{2}$ ^oW. 90.4 ft.)
- A Douglas Fir 30 inch diam. w/open blaze bears N. 35 $\frac{1}{2}$ ^oW. 57.8 ft. (record N. 35^oW. 59.4 ft.)
- A dead-standing Douglas Fir 24 inch diam. bears S. 84^oE. 33.0 ft. (record S. 83 $\frac{1}{2}$ ^oE. 33.7 ft.)

Bearing tree recorded by Ramsey:

- A dead-standing D. Fir 9 inch diam. bears N. 22 $\frac{1}{2}$ ^oE. 137.6 ft. (record N. 20^oE. 139.9 ft.)


I set a 2 inch diam. x 30 inch G.I.P. over the found pipe with a 2 $\frac{1}{2}$ inch brass cap marked

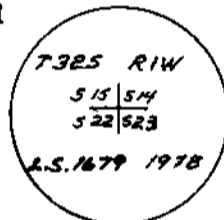

and take the following new bearing trees and place a brass washer bearing my registration No. in the lower blaze:

- A Douglas Fir 6 inch diam. marked "T32S R1W S. 14 BT" bears N. 70 $\frac{1}{2}$ ^oE. 26.5 ft.
- A Douglas Fir 6 inch diam. marked "T32S R1W S. 23 BT" bears S. 1^oE. 25.1 ft.

Va. = 21^o

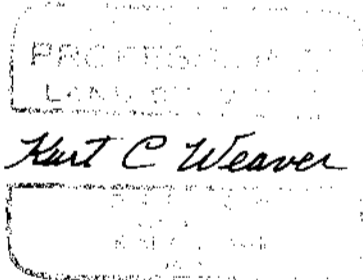

I hereby certify the above corner perpetuated as herein described on November 17, 1978.

Witnesses:

Herb Farber
Reg Harding

Office of Surveyor County of Douglas,
State of Oregon, I hereby certify that the
within instrument was filed in this office
for record on 8 th day of December, 1978

Francis L. Ingram by Virginia A. Sanger
County Surveyor Deputy

Handwritten initials

#70 X

58/176-6