

*W. Julian*  
Home Phones:  
N. Juliano 343-5288  
Don Peel 344-1828  
L. Roberts 686-0203



# Triangle Engineering Co.

1262 Lawrence (Suite 4) EUGENE, OR ~~97041~~ 97401  
Phone: (503) 343-7323

September 4, 1979

County of Douglas  
Office of the Surveyor  
Roseburg, OR 97470

Subject:  $\frac{1}{2}$  corner 26 & 35, T 23 S, R 2 W, W.M.

During a recent logging operation in the vicinity of said corner, several of the bearing trees were knocked out. I found the brass cap (Douglas Co. "1969") in place, in a mound of stone. The original B.T. to the northeast is the only B.T. remaining. The two new B.T.s (C.S. File # 54/27) and the hemlock snag in the southeast are now down. I scribed a 42 inch fir stump, S 1 E, 63.3 ft. (scribed  $\frac{1}{2}$ s35 BT), for the Section 35 bearing tree. Enclosed is a Lane County restored corner card with the corner information on it.

Sincerely yours,

Donald L. Peel  
P.L.S. #752

FILED  
RECEIVED ✓  
SEP 18 1979  
SURVEYOR  
LANE COUNTY, ORE

#34 ✓

C. S. File No. 58/176-8C

**RESTORED CORNER**

Index

Corner 1/4 CORNER BTWN SECS. 26 & 35 T 235 R 2W

From G.L.O. Notes dated: \_\_\_\_\_ Evidence Found: AUGUST 28, 1979

Corner \_\_\_\_\_ Corner \_\_\_\_\_

Witness \_\_\_\_\_ 40" FIR, N43E, 21<sup>8</sup> FT. (CLOSED PACE)

Marks \_\_\_\_\_

Reestablishment Notes dated 1969 Evidence Found AUGUST 28 1979


Corner BRASS CAP Corner 1/4" IRON PIPE WITH

Witness 7" HEMLOCK N49E, 23.0 FT DOUGLAS CO. BRASS CAP IN

Marks 11" HEMLOCK, S39E, 21.1 FT. MOUND OF STONE ("1969")

Restoration Notes: \_\_\_\_\_

I SCRIBED A 42" FIR STUMP (4535 BT)  
S 1 E, 63.3 FT.

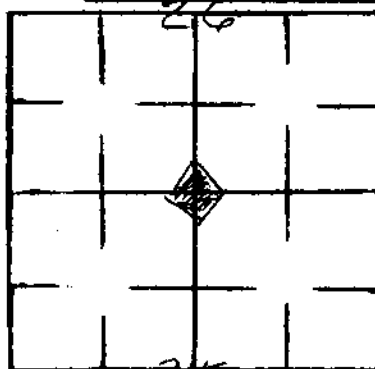

State Coordinates N= \_\_\_\_\_ S= \_\_\_\_\_

AUG. 28 1979 Donald G. Peal ORE. PLS 0752

(Date) (Signature) (Title)

(use back of card for diagram)


— OVER —

U. S. File No. 58/176-8

ACOR  $\frac{26}{35}$   
1 1/2" IRON PIPE WITH B.C.  
IN MOUND OF  
STONE



N 43 E  
218

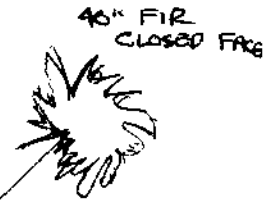

31 E  
63

VAR. 20°



SCRIBED  
ACOR  
51